

USE TYPEWRITER OR BALL POINT PEN-PRESS FIRMLY, PRINT CLEARLY.


T R EW sec 1/4 1/4 1/4 No.

WATER WELL RECORD
KSA 82a-1201-1215

Kansas State Dept. Of Health
(Water Well Contractors)
Forbes-Bldg. 740
Topeka, Kansas 66620

1 Location of well:	County HARVEY	Township name Newton	Fraction NW 1/4 NE 1/4	Section number 8	Town number T23S	Range number R1E
---------------------	-------------------------	--------------------------------	----------------------------------	----------------------------	----------------------------	----------------------------

Distance and direction from nearest town or city: 1/2 N North Newton	3 Owner of well: D.C. Wedel
Street address of well location if in city: 210 E 23rd	Address: 210 E 23rd N. NEWTON KANS

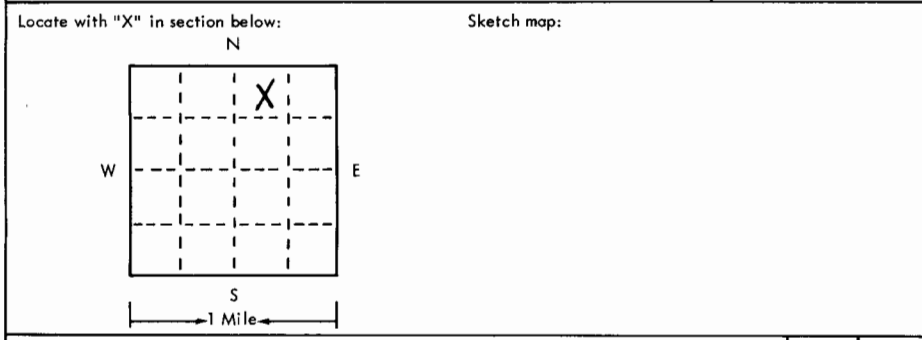

4 Well depth: **40** ft. Date of completion **3/7/75**
Well diameter **12** in.

5 Cable tool Rotary Driven Dug
 Hollow rod Jetted Bored Reverse rotary

6 Use: Domestic Public supply Industry
 Irrigation Air conditioning Commercial
 Test well

7 Casing: Material **PVC** Height: **above** below
Threaded Welded Surface **12** in.
Dia. **6"** Weight **3.3** lbs./ft.
6 in. to **40'** ft. depth Drive shoe? Yes No
___ in. to ___ ft. depth!

2	Type and color of material	From	To
	LOAM	0	5
	SANDY CLAY	5	7
	SAND brown - medium size	7	11
	SAND w small amounts of clay	11	16
	SAND - mostly Sharp - with some thin clay layers	16	29
	SANDY - White Shale	29	31
	Grey Shale	31	34
	dark hard shale "Wellington"	34	40
	(use a second sheet if needed)		

8 Screen: Manufacturer **Centin-Tool**
Type **PVC** Dia. **6"**
Slot/gauze **0.064** Length **15'**
Set between **15** ft. and **30** ft.
Fittings: **1/8 - 1/2" #8**
Gravel pack Yes No Size range of material **#8**

9 Static water level:
9' ft. below land surface Date **3/7/75**

10 Pumping level below land surfaces:
12 ft. after **1** hrs. pumping **15** g.p.m.
___ ft. after ___ hrs. pumping ___ g.p.m.
Estimated maximum yield ___ g.p.m.

11 Water sample submitted:
 Yes No Date ___

12 Well head completion:
 Pitless adapter Inches above grade

13 Well grouted? Yes No
 Neat cement Bentonite ___
Depth: From **0** ft. to **15** ft.

14 Nearest source of possible contamination:
ft. **75** Direction **South** Type **SEWER**
Well disinfected upon completion? Yes No

15 Pump: Not installed
Manufacturer's name ___
Model number ___ HP ___ Volts ___
Length of drop pipe ___ ft. capacity ___ g.m.p.
Type:
 Submersible Turbine
 Jet Reciprocating
 Centrifugal Other

16 Remarks: elevation

Topography:
 Hill
 Slope
 Upland
 Valley

17 Water well contractor's certification:
This well was drilled under my jurisdiction and this report is true to the best of my knowledge and belief.

PAUL'S INC. 175
Business name License No.
Address **Box 26 - Hesston, KANS**
Signed **Paul Paulson** Date **3/8/75**
Authorized representative