


1 LOCATION OF WATER WELL: County: **HARVEY** Fraction: **NW 1/4 NE 1/4 NW 1/4** Section Number: **8** Township Number: **T 23 S** Range Number: **R 1-E E/W**

Distance and direction from nearest town or city street address of well if located within city?
305 W 23RD N NEWTON KS

2 WATER WELL OWNER: **GJELDON KLAASSEN**
 RR#, St. Address, Box #: **305 W 23RD**
 City, State, ZIP Code: **N NEWTON KS. 67117**
 Board of Agriculture, Division of Water Resources
 Application Number:

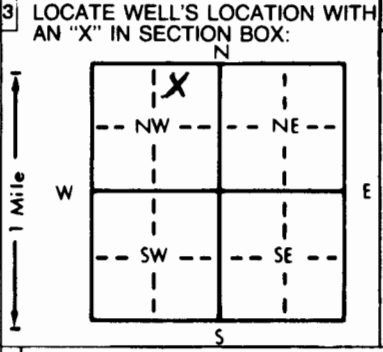

4 DEPTH OF COMPLETED WELL: **62** ft. ELEVATION: **FAT**
 Depth(s) Groundwater Encountered 1. **30** ft. 2. ft. 3. ft.
 WELL'S STATIC WATER LEVEL **1.2** ft. below land surface measured on **4-15-92**
 Pump test data: Well water was **45** ft. after **2** hours pumping **15** gpm
 Est. Yield **15** gpm: Well water was ft. after hours pumping gpm
 Bore Hole Diameter **9** in. to **62** ft., and in. to ft.
 WELL WATER TO BE USED AS:
 5 Public water supply 8 Air conditioning 11 Injection well
 1 Domestic 3 Feedlot 6 Oil field water supply 9 Dewatering 12 Other (Specify below)
 2 Irrigation 4 Industrial **7** Lawn and garden only 10 Monitoring well
 Was a chemical/bacteriological sample submitted to Department? Yes. No. **X**; If yes, mo/day/yr sample was submitted
 Water Well Disinfected? **Yes** No

5 TYPE OF BLANK CASING USED:
 1 Steel 3 RMP (SR) 5 Wrought iron 8 Concrete tile CASING JOINTS: Glued **X** Clamped
2 PVC 4 ABS 7 Fiberglass Welded
 Blank casing diameter **5** in. to **62** ft., Dia in. to ft., Dia in. to ft.
 Casing height above land surface **24** in., weight **2.29** lbs./ft. Wall thickness or gauge No. **214**
 TYPE OF SCREEN OR PERFORATION MATERIAL:
 1 Steel 3 Stainless steel 5 Fiberglass **7** PVC 10 Asbestos-cement
 2 Brass 4 Galvanized steel 6 Concrete tile 9 ABS 11 Other (specify)
 12 None used (open hole)
 SCREEN OR PERFORATION OPENINGS ARE:
 1 Continuous slot 3 Mill slot 5 Gauzed wrapped **8** Saw cut 11 None (open hole)
 2 Louvered shutter 4 Key punched 6 Wire wrapped 9 Drilled holes
 7 Torch cut 10 Other (specify)
 SCREEN-PERFORATED INTERVALS: From **42** ft. to **62** ft., From ft. to ft.
 From ft. to ft., From ft. to ft.
 GRAVEL PACK INTERVALS: From **10** ft. to **62** ft., From ft. to ft.
 From ft. to ft., From ft. to ft.

6 GROUT MATERIAL: 1 Neat cement 2 Cement grout **3** Bentonite 4 Other
 Grout Intervals: From **0** ft. to **10** ft., From ft. to ft., From ft. to ft.
 What is the nearest source of possible contamination:
 1 Septic tank 4 Lateral lines 7 Pit privy 10 Livestock pens 14 Abandoned water well
 2 Sewer lines 5 Cess pool 8 Sewage lagoon 11 Fuel storage 15 Oil well/Gas well
3 Watertight sewer lines 6 Seepage pit 9 Feedyard 12 Fertilizer storage 16 Other (specify below)
 13 Insecticide storage
 Direction from well? **EAST** How many feet? **45**

| FROM | TO | LITHOLOGIC LOG | FROM | TO | PLUGGING INTERVALS |
|------|----|----------------|------|----|--------------------|
| 0 | 30 | CLAY | | | |
| 30 | 40 | CLAY SAND MIX | | | |
| 40 | 62 | SHALE | | | |
| | | | | | |
| | | | | | |
| | | | | | |
| | | | | | |
| | | | | | |
| | | | | | |
| | | | | | |

7 CONTRACTOR'S OR LANDOWNER'S CERTIFICATION: This water well was **1** constructed, (2) reconstructed, or (3) plugged under my jurisdiction and was completed on (mo/day/year) **4-15-92** and this record is true to the best of my knowledge and belief. Kansas Water Well Contractor's License No. **362** This Water Well Record was completed on (mo/day/yr) **12-28-92** under the business name of **MARTEL Supply** by (signature) **Burt Johnson**

OFFICE USE ONLY