


COPY - HP

1 LOCATION OF WATER WELL: Fraction SW 1/4 NE 1/4 NW 1/4 Section Number 8 Township Number 7 Range Number 23 1 E 4
 County: H Harvey North Newton City Westside Addition Lot 7 Block 9 Newton

Distance and direction from nearest town or city street address of well if located within city?
2309 Berry St., North Newton, Kansas 67114

2 WATER WELL OWNER: Orville Fenner
 RR#, St. Address, Box #: 2309 Berry St.
 City, State, ZIP Code: North Newton, Kansas 67114
 Board of Agriculture, Division of Water Resources
 Application Number: _____

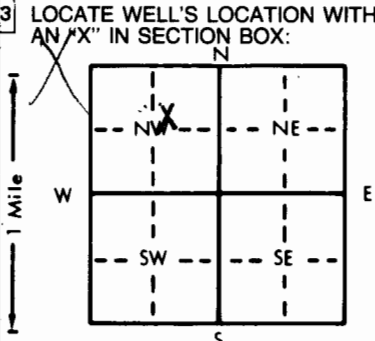

4 DEPTH OF COMPLETED WELL: 70 ft. ELEVATION: _____
 Depth(s) Groundwater Encountered 1. 10 ft. 2. 30 ft. 3. 60 ft.
 WELL'S STATIC WATER LEVEL: 10 ft. below land surface measured on mo/day/yr July 14, 1981
 Pump test data: Well water was ? ft. after 8 hours pumping 4 gpm
 Est. Yield 4 gpm: Well water was ? **Could not measure** hours pumping _____ gpm
 Bore Hole Diameter: 4 in. to to bottom of well in. to _____ in.
 WELL WATER TO BE USED AS:
 5 Public water supply 8 Air conditioning? 11 Injection well
 1 Domestic 3 Feedlot 6 Oil field water supply 9 Dewatering 12 Other (Specify below)
 2 Irrigation 4 Industrial 7 Lawn and garden use 10 Observation well
 Was a chemical/bacteriological sample submitted to Department? Yes _____ No X If yes, mo/day/yr sample was submitted _____
 Water Well Disinfected? Yes _____ No X

5 TYPE OF BLANK CASING USED:
 1 Steel 3 RMP (SR) 5 Wrought iron 8 Concrete tile CASING JOINTS: Glued _____ Clamped _____
 2 PVC 4 ABS 6 Asbestos-Cement 9 Other (specify below) Welded _____
 7 Fiberglass _____ Threaded _____
 Blank casing diameter: 2 in. to bottom of well in. to _____ ft., Dia. _____ in. to _____ ft.
 Casing height above land surface: 12 in., weight _____ lbs./ft. Wall thickness or gauge No. _____
 TYPE OF SCREEN OR PERFORATION MATERIAL:
 1 Steel 3 Stainless steel 5 Fiberglass 8 PVC 10 Asbestos-cement
 2 Brass 4 Galvanized steel 6 Concrete tile 9 ABS 11 Other (specify) _____
 12 None used (open hole)
 SCREEN OR PERFORATION OPENINGS ARE:
 1 Continuous slot 3 Mill slot 5 Gauzed wrapped 8 Saw cut 11 None (open hole)
 2 Louvered shutter 4 Key punched 6 Wire wrapped 9 Drilled holes
 7 Torch cut 10 Other (specify) Plastic Screen
 SCREEN-PERFORATED INTERVALS: From 66 ft. to 71 ft., From _____ ft. to _____ ft.
 GRAVEL PACK INTERVALS: From 10 ft. to bottom ft., From _____ ft. to _____ ft.

6 GROUT MATERIAL: 1 Neat cement 2 Cement grout 3 Bentonite 4 Other _____
 Grout Intervals: From 0 ft. to 10 ft., From _____ ft. to _____ ft., From _____ ft. to _____ ft.
 What is the nearest source of possible contamination:
 1 Septic tank 4 Lateral lines 7 Pit privy 10 Livestock pens 14 Abandoned water well
 2 Sewer lines? 5 Cess pool 8 Sewage lagoon 11 Fuel storage 15 Oil well/Gas well
 3 Waterproof sewer lines 6 Seepage pit 9 Feedyard 12 Fertilizer storage 16 Other (specify below)
 13 Insecticide storage
 Direction from well? South How many feet? 25

FROM	TO	LITHOLOGIC LOG	FROM	TO	LITHOLOGIC LOG
1	3	Black soil	Installed		1/2 H. P. Jet Pump with Sears Jet Kit (Deep Well) for 2" Casing and 1" PVC Plastic pipe inside. Hope to use for heating & air conditioning later on.
3	20	Clay	Sears Jet		
20	25	Grey Clay	and 1"		
25	30	Grey to Blue Clay			
30	35	Blue Clay, hard at 32			
35	40	Blue Clay			
40	50	Black Shale			
50	65	Grey Clay			
65	70	Black Shale			

7 CONTRACTOR'S OR LANDOWNER'S CERTIFICATION: This water well was (1) constructed, (2) reconstructed, or (3) plugged under my jurisdiction and was completed on (mo/day/year) July 14, 1981 and this record is true to the best of my knowledge and belief. Kansas Water Well Contractor's License No. 390 This Water Well Record was completed on (mo/day/yr) July 30, 1981 under the business name of Home Water Well Drilling by (signature) [Signature]

INSTRUCTIONS: Use typewriter or ball point pen, PLEASE PRESS FIRMLY and PRINT clearly. Please fill in blanks, underline or circle the correct answers. Send top three copies to Kansas Department of Health and Environment, Division of Environment, Environmental Geology Section, Topeka, KS 66620. Send one to WATER WELL OWNER and retain one for your records.