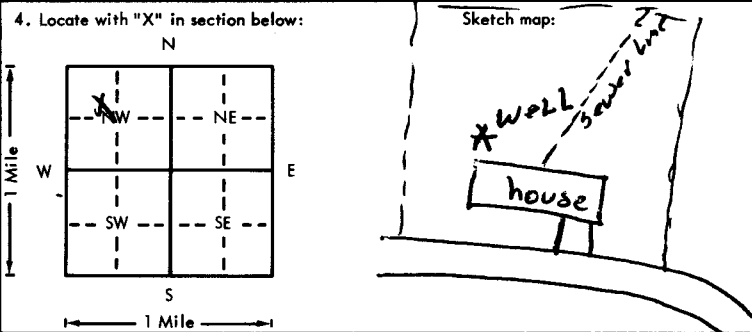


USE TYPEWRITER OR BALL POINT PEN-PRESS FIRMLY, PRINT CLEARLY.

WATER WELL RECORD
KSA 82a-1201-1215

Kansas Department of Health and Environment-Division of Environment
(Water well Contractors)
Topeka, Kansas 66620

1. Location of well:		County HARVEY	Fraction 1/4 NW 1/4 NW 1/4	Section number 8	Township number T 23 S R	Range number 1 E/W
2. Distance and direction from nearest town or city: Street address of well location if in city: SAME				3. Owner of well: Henry Nightengole R.R. or street: 615 Michael Rd City, state, zip code: Newton, KMS		
4. Locate with "X" in section below: 				6. Bore hole dia. 12 in. Completion date 8/20/76 Well depth 46 ft.		
				7. <input type="checkbox"/> Cable tool <input checked="" type="checkbox"/> Rotary <input type="checkbox"/> Driven <input type="checkbox"/> Dug <input type="checkbox"/> Hollow rod <input type="checkbox"/> Jetted <input type="checkbox"/> Bored <input type="checkbox"/> Reverse rotary		
				8. Use: <input type="checkbox"/> Domestic <input type="checkbox"/> Public supply <input type="checkbox"/> Industry <input checked="" type="checkbox"/> Irrigation <input type="checkbox"/> Air conditioning <input type="checkbox"/> Stock <input checked="" type="checkbox"/> Lawn <input type="checkbox"/> Oil field water <input type="checkbox"/> Other		
				9. Casing: Material PVC Height: Above or below Threaded <input type="checkbox"/> Welded <input checked="" type="checkbox"/> Surface 12 in. RMP <input type="checkbox"/> PVC <input checked="" type="checkbox"/> Weight 3.23 lbs./ft. Dia. 6 in. to 46 ft. depth Wall Thickness: inches or Dia. <input type="checkbox"/> in. to <input type="checkbox"/> ft. depth gage No. 255		
5. Type and color of material				From	To	10. Screen: Manufacturer's name Robin Tech - own slot
loam				0	2	Type PVC Dia. 6"
brown clay				2	4	Slot/gauze 0.04 Length 4' 26"
fine dune sand				4	7	Set between 20 ft. and 46 ft.
brown clay				7	14	Gravel pack? <input checked="" type="checkbox"/> Size range of material 1/8-1/4
clay & sand mix				14	30	11. Static water level: mo./day/yr. 14' ft. below land surface Date 8/20/76
fine sand				30	32	12. Pumping level below land surfaces: 24 ft. after 2 hrs. pumping 20 g.p.m.
clay & sand mix				32	41	ft. after _____ hrs. pumping _____ g.p.m.
medium to coarse sand				41	45	Estimated maximum yield 25-30 g.p.m.
blue green shale				45	46	13. Water sample submitted: mo./day/yr. <input type="checkbox"/> Yes <input checked="" type="checkbox"/> No Date _____
						14. Well head completion: <input type="checkbox"/> Pitless adapter 12 inches above grade
						15. Well grouted? <input checked="" type="checkbox"/> With: <input checked="" type="checkbox"/> Neat cement <input type="checkbox"/> Bentonite <input type="checkbox"/> Concrete Depth: From 10 ft. to 0 ft.
						16. Nearest source of possible contamination: house ft. RR Direction WEST Type SEWER Well disinfected upon completion? <input type="checkbox"/> Yes <input checked="" type="checkbox"/> No
						17. Pump: _____ Not installed Manufacturer's name VALLEY Model number S-1808 HP 1/2 Volts 230 Length of drop pipe _____ ft. capacity 20 g.p.m. Type: <input checked="" type="checkbox"/> Submersible <input type="checkbox"/> Turbine <input type="checkbox"/> Jet <input type="checkbox"/> Reciprocating <input type="checkbox"/> Centrifugal <input type="checkbox"/> Other
(Use a second sheet if needed)						
18. Elevation:		19. Remarks:		20. Water well contractor's certification: This well was drilled under my jurisdiction and this report is true to the best of my knowledge and belief. PAUL'S INC. 175 Business name License No. Address 400 N LANCASTER, HOUSTON Signed Paul Buehler Date _____ Authorized representative		
Topography: <input type="checkbox"/> Hill <input type="checkbox"/> Slope <input type="checkbox"/> Upland <input type="checkbox"/> Valley						

23 - 10 - 8 SE 1/4 NW 1/4