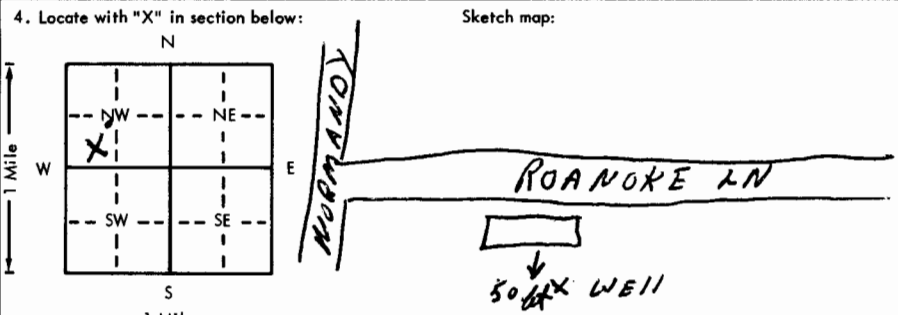


USE TYPEWRITER OR BALL POINT PEN-PRESS FIRMLY, PRINT CLEARLY.

WATER WELL RECORD  
KSA 82a-1201-1215

Kansas Department of Health and Environment-Division of Environment  
(Water well Contractors)  
Topeka, Kansas 66620

1. Location of well: County <b>HARVEY</b> Fraction <b>NE 1/4 SW 1/4 NW 1/4</b> Section number <b>8</b> Township number <b>T 23 S R 1-E</b> Range number <b>E</b>	
2. Distance and direction from nearest town or city: Street address of well location if in city: <b>2006 ROANOKE LN NEWTON KS 67114</b>	
3. Owner of well: <b>RL SPENCER</b> R.R. or street: <b>2006 ROANOKE LN</b> City, state, zip code: <b>NEWTON KS 67114</b>	
4. Locate with "X" in section below:  Sketch map:	
5. Type and color of material	
	From To
<b>TOP SOIL</b>	<b>0 2</b>
<b>CLAY BROWN</b>	<b>2 27</b>
<b>SAND FINE</b>	<b>27 30</b>
<b>SAND FINE TO COARSE</b>	<b>30 42</b>
<b>SHALE GRAY BLACK</b>	<b>42 60</b>
(Use a second sheet if needed)	
18. Elevation:	19. Remarks:
Topography: <input type="checkbox"/> Hill <input type="checkbox"/> Slope <input checked="" type="checkbox"/> Upland <input type="checkbox"/> Valley	20. Water well contractor's certification: This well was drilled under my jurisdiction and this report is true to the best of my knowledge and belief. <b>D &amp; R Well Service</b> License No. <b>211</b> Address <b>428 W 3rd Newton, Mo</b> Signed <b>William Williams</b> Date <b>6-24-76</b> Authorized representative

6. Bore hole dia. **10** in. Completion date **6-5-76**  
Well depth **60** ft.

7.  Cable tool  Rotary  Driven  Dug  
 Hollow rod  Jetted  Bored  Reverse rotary

8. Use:  Domestic  Public supply  Industry  
 Irrigation  Air conditioning  Stock  
 Lawn  Oil field water  Other

9. Casing: Material **PVC** Height: **Above** or below  
Threaded  Welded  Surface **18** in.  
**RMP**  PVC  Weight  lbs./ft.  
Dia. **5** in. to **60** ft. depth Wall Thickness: inches or  
Dia.  in. to  ft. depth gage No. **200**

10. Screen: Manufacturer's name **J & L**  
Type **RMP** Dia. **5 in**  
Slot/gauge **.06** Length **40**  
Set between **20** ft. and **60** ft.  
Gravel pack? **YES** Size range of material **1/8-1/4**

11. Static water level: **20** ft. below land surface Date **6-1-76** mo./day/yr.

12. Pumping level below land surfaces:  
**35** ft. after **1** hrs. pumping **20** g.p.m.  
ft. after  hrs. pumping  g.p.m.  
Estimated maximum yield **20** g.p.m.

13. Water sample submitted:  Yes  No Date

14. Well head completion:  
**NO** Pitless adapter **18** Inches above grade

15. Well grouted? **YES**  
With:  Neat cement  Bentonite  Concrete  
Depth: From **0** ft. to **12** ft.

16. Nearest source of possible contamination: **SEWER**  
ft. **60** Direction **N** Type **LINE**  
Well disinfected upon completion?  Yes  No

17. Pump:  Not installed  
Manufacturer's name **PUMP CO**  
Model number **102558** HP **1/2** Volts **220**  
Length of drop pipe **45** ft. capacity **12** g.p.m.  
Type:  
 Submersible  Turbine  
 Jet  Reciprocating  
 Centrifugal  Other

23 - 10 - 8 NE SW NW  
R 1 W 1/4 1/4 1/4

Forward the white, blue and pink copies to the Department of Health and Environment

Form WWC-5