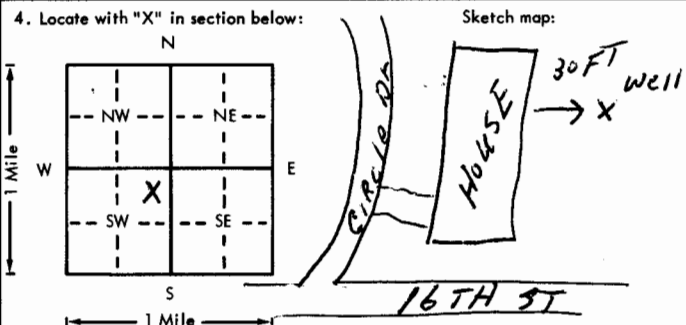


USE TYPEWRITER OR BALL POINT PEN-PRESS FIRMLY, PRINT CLEARLY.

WATER WELL RECORD
KSA 82a-1201-1215

Kansas Department of Health and Environment-Division of Environment
(Water well Contractors)
Topeka, Kansas 66620

1. Location of well:		County HARVEY	Fraction NE 1/4 NE 1/4 SW 1/4	Section number 8	Township number T 23 S	Range number R - 1 - E E/W
2. Distance and direction from nearest town or city: Street address of well location if in city: 10 CIRCLE DR				3. Owner of well: O.E. SPENCER R.R. or street: 10 CIRCLE DR City, state, zip code: NEWTON KS 67114		
4. Locate with "X" in section below: 				6. Bore hole dia. 10 in. Completion date 6-1-76 Well depth 65 ft.		
5. Type and color of material				7. <input type="checkbox"/> Cable tool <input checked="" type="checkbox"/> Rotary <input type="checkbox"/> Driven <input type="checkbox"/> Dug <input type="checkbox"/> Hollow rod <input type="checkbox"/> Jetted <input type="checkbox"/> Bored <input type="checkbox"/> Reverse rotary		
				8. Use: <input type="checkbox"/> Domestic <input type="checkbox"/> Public supply <input type="checkbox"/> Industry <input checked="" type="checkbox"/> Irrigation <input type="checkbox"/> Air conditioning <input type="checkbox"/> Stock <input checked="" type="checkbox"/> Lawn <input type="checkbox"/> Oil field water <input type="checkbox"/> Other		
				9. Casing: Material PITS Height: <input checked="" type="checkbox"/> Above or below Threaded <input type="checkbox"/> Welded <input type="checkbox"/> Surface 18 in. RMP <input checked="" type="checkbox"/> PVC <input type="checkbox"/> Weight _____ lbs./ft. Dia. 5 in. to 65 ft. depth Wall Thickness: inches or Dia. _____ in. to _____ ft. depth gage No. 200		
				10. Screens: Manufacturer's name J&L Type RMP Dia. 5 in <input checked="" type="checkbox"/> gauze 106 Length 40 ft Set between 25 ft. and 65 ft. Gravel pack? yes Size range of material 1/8-1/4		
				11. Static water level: _____ mo./day/yr. 15 ft. below land surface Date 5-20-76		
				12. Pumping level below land surfaces: 20 ft. after 1 hrs. pumping 25 g.p.m. _____ ft. after _____ hrs. pumping _____ g.p.m. Estimated maximum yield 35 g.p.m.		
				13. Water sample submitted: _____ mo./day/yr. <input type="checkbox"/> Yes <input checked="" type="checkbox"/> No Date _____		
				14. Well head completion: <input checked="" type="checkbox"/> Pitless adapter 18 inches above grade		
				15. Well grouted? yes With: <input checked="" type="checkbox"/> Neat cement <input type="checkbox"/> Bentonite <input type="checkbox"/> Concrete Depth: From 4 ft. to 15 ft.		
				16. Nearest source of possible contamination: SEWER ft. 50 Direction W Type LINE Well disinfected upon completion? <input checked="" type="checkbox"/> Yes <input type="checkbox"/> No		
				17. Pump: _____ Not installed Manufacturer's name PUMP CO Model number 102558 HP 1/2 Volts 220 Length of drop pipe 55 ft. capacity 12 g.p.m. Type: <input checked="" type="checkbox"/> Submersible <input type="checkbox"/> Turbine <input type="checkbox"/> Jet <input type="checkbox"/> Reciprocating <input type="checkbox"/> Centrifugal <input type="checkbox"/> Other		
				20. Water well contractor's certification: This well was drilled under my jurisdiction and this report is true to the best of my knowledge and belief. DTR Well Service 211 Business name _____ License No. _____ Address 428 W 3RD Newton ks Signed W. B. Williams Date 6-24-76 Authorized representative		
18. Elevation:		19. Remarks:				
Topography: <input type="checkbox"/> Hill <input type="checkbox"/> Slope <input checked="" type="checkbox"/> Upland <input type="checkbox"/> Valley						

23 - 10 - 8 NE NE SW
T 23 R 10 S 8 NE NE SW
1/4 1/4 1/4