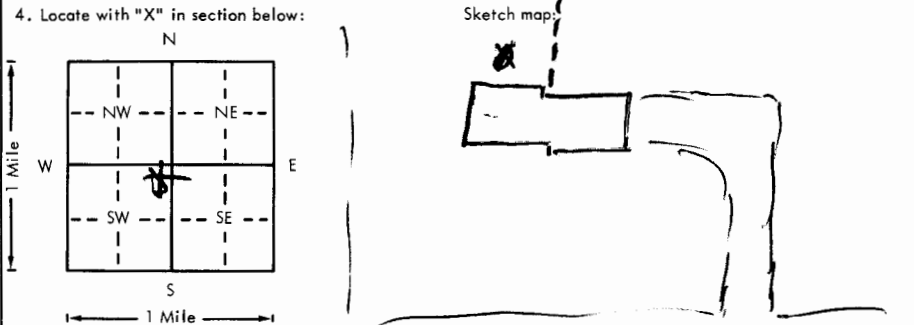


USE TYPEWRITER OR BALL POINT PEN-PRESS FIRMLY, PRINT CLEARLY.

WATER WELL RECORD  
KSA 82a-1201-1215

Kansas Department of Health and Environment-Division of Environment  
(Water well Contractors)  
Topeka, Kansas 66620

1. Location of well:	County <b>HARVEY</b>	Fraction <b>NE 1/4 NE 1/4 SW 1/4</b>	Section number <b>8</b>	Township number <b>T 23 S R</b>	Range number <b>1</b> <span style="float:right;">E/W</span>																										
2. Distance and direction from nearest town or city: Street address of well location if in city:			3. Owner of well: R.R. or street: City, state, zip code:																												
4. Locate with "X" in section below: 			6. Bore hole dia. <b>14</b> in. Completion date Well depth <b>100</b> ft. <b>5/31/79</b>																												
5. Type and color of material			7. <input type="checkbox"/> Cable tool <input checked="" type="checkbox"/> Rotary <input type="checkbox"/> Driven <input type="checkbox"/> Dug <input type="checkbox"/> Hollow rod <input type="checkbox"/> Jetted <input type="checkbox"/> Bored <input type="checkbox"/> Reverse rotary																												
<table border="1" style="width:100%; border-collapse: collapse;"> <thead> <tr> <th style="width:80%;">From</th> <th style="width:20%;">To</th> </tr> </thead> <tbody> <tr><td><b>LOAM TO RED BROWN CLAY</b></td><td><b>0 5</b></td></tr> <tr><td><b>LIGHT BR. CLAY</b></td><td><b>5 15</b></td></tr> <tr><td><b>" " " SANDY</b></td><td><b>15 20</b></td></tr> <tr><td><b>DARK GREY CLAY</b></td><td><b>20 39</b></td></tr> <tr><td><b>SAND / fossil shells</b></td><td><b>39 40</b></td></tr> <tr><td><b>GREEN - GREY SHALE</b></td><td><b>40 45</b></td></tr> <tr><td><b>" " to GREY (white) (w/brickly)</b></td><td><b>45 55</b></td></tr> <tr><td><b>GREY SHALE / BROWN SHALE</b></td><td><b>55 60</b></td></tr> <tr><td><b>LAYERED</b></td><td></td></tr> <tr><td><b>GREY - Blue Shale w/clear crystals</b></td><td><b>60 65</b></td></tr> <tr><td><b>GREY SHALE w/white nodules</b></td><td><b>65 70</b></td></tr> <tr><td><b>Blue GREY SHALE</b></td><td><b>70 100</b></td></tr> </tbody> </table>			From	To	<b>LOAM TO RED BROWN CLAY</b>	<b>0 5</b>	<b>LIGHT BR. CLAY</b>	<b>5 15</b>	<b>" " " SANDY</b>	<b>15 20</b>	<b>DARK GREY CLAY</b>	<b>20 39</b>	<b>SAND / fossil shells</b>	<b>39 40</b>	<b>GREEN - GREY SHALE</b>	<b>40 45</b>	<b>" " to GREY (white) (w/brickly)</b>	<b>45 55</b>	<b>GREY SHALE / BROWN SHALE</b>	<b>55 60</b>	<b>LAYERED</b>		<b>GREY - Blue Shale w/clear crystals</b>	<b>60 65</b>	<b>GREY SHALE w/white nodules</b>	<b>65 70</b>	<b>Blue GREY SHALE</b>	<b>70 100</b>	8. Use: <input type="checkbox"/> Domestic <input type="checkbox"/> Public supply <input type="checkbox"/> Industry <input type="checkbox"/> Irrigation <input type="checkbox"/> Air conditioning <input type="checkbox"/> Stock <input checked="" type="checkbox"/> Lawn <input type="checkbox"/> Oil field water <input type="checkbox"/> Other		
			9. Casing: Material <b>Plastic</b> Height <b>Above</b> or below Threaded <input type="checkbox"/> Welded <input checked="" type="checkbox"/> Surface <b>12</b> in. RMP <input type="checkbox"/> PVC <input checked="" type="checkbox"/> Weight <b>3.68</b> lbs./ft. Dia. <b>6</b> in. to <b>100</b> ft. depth Wall Thickness: inches or Dia. <input type="checkbox"/> in. to <input type="checkbox"/> ft. depth gage No. <b>280</b>																												
			10. Screen: Manufacturer's name <b>Peerless</b> Type <input type="checkbox"/> Dia. <b>6"</b> Slot/gauze <b>.030</b> Length <b>10</b> Set between <b>96</b> ft. and <b>81</b> ft. <b>44</b> ft. and <b>39</b> ft. Gravel pack? <input checked="" type="checkbox"/> Size range of material <b>1/8 - 1/4</b>																												
			11. Static water level: <input type="checkbox"/> mo./day/yr. <b>15</b> ft. below land surface Date <b>5/24/79</b>																												
			12. Pumping level below land surfaces: <b>95</b> ft. after <b>2</b> hrs. pumping <b>6/8</b> g.p.m. <input type="checkbox"/> ft. after <input type="checkbox"/> hrs. pumping <input type="checkbox"/> g.p.m. Estimated maximum yield <b>6 to 8</b> g.p.m.																												
			13. Water sample submitted: <input type="checkbox"/> mo./day/yr. Yes <input checked="" type="checkbox"/> No Date																												
			14. Well head completion: <input type="checkbox"/> Pitless adapter <b>12</b> Inches above grade																												
			15. Well grouted? <input checked="" type="checkbox"/> With: <input checked="" type="checkbox"/> Neat cement <input type="checkbox"/> Bentonite <input type="checkbox"/> Concrete Depth: From <b>10</b> ft. to <b>0</b> ft.																												
			16. Nearest source of possible contamination: ft. <b>25</b> Direction <b>NE</b> Type <b>Sewer line</b> Well disinfected upon completion? <input type="checkbox"/> Yes <input checked="" type="checkbox"/> No																												
			17. Pump: Manufacturer's name <b>Dempster</b> Not installed Model num <b>MB63-33-13</b> Vol <b>280</b> Length of drop pipe <b>90</b> ft. capacity <b>12</b> g.p.m. Type: <input checked="" type="checkbox"/> Submersible <input type="checkbox"/> Turbine <input type="checkbox"/> Jet <input type="checkbox"/> Reciprocating <input type="checkbox"/> Centrifugal <input type="checkbox"/> Other																												
			20. Water well contractor's certification: This well was drilled under my jurisdiction and this report is true to the best of my knowledge and belief. <b>PAUL'S TAIG #175</b> Business name License No. Address <b>Box 26 - Hesston</b> Signed <b>Paul Paulig</b> Date <b>7/10/79</b> Authorized representative																												
18. Elevation:  Topography: <input type="checkbox"/> Hill <input type="checkbox"/> Slope <input type="checkbox"/> Upland <input type="checkbox"/> Valley	19. Remarks:  (Use a second sheet if needed)																														

Forward the white, blue and pink copies to the Department of Health and Environment

Form WWC-5

23 W  
 100  
 NE NE SW  
 1/4 1/4 23  
 Sec