


1 LOCATION OF WATER WELL: County: Harvey Fraction: NW 1/4 NW 1/4 NW 1/4 Section Number: 9 Township Number: T 23 S Range Number: 1 E

Distance and direction from nearest town or city street address of well if located within city? Non mains to 24th and E 1/4 miles on S of R

2 WATER WELL OWNER: Elmer R W Lens
 RR#, St. Address, Box #: E 24 ST
 City, State, ZIP Code: Newton Kansas
 Board of Agriculture, Division of Water Resources
 Application Number:

3 LOCATE WELL'S LOCATION WITH AN "X" IN SECTION BOX:

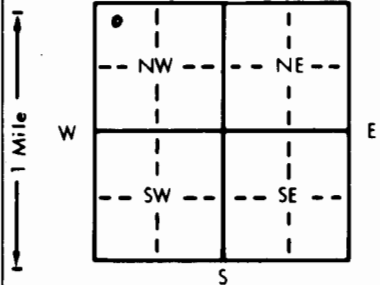

4 DEPTH OF COMPLETED WELL: 78 ft. ELEVATION:

Depth(s) Groundwater Encountered 1. _____ ft. 2. _____ ft. 3. _____ ft.
 WELL'S STATIC WATER LEVEL: 20 ft. below land surface measured on mo/day/yr Mar 21 1990
 Pump test data: Well water was 19 ft. after 2 hours pumping 12 gpm
 Est. Yield 12 gpm: Well water was _____ ft. after _____ hours pumping _____ gpm
 Bore Hole Diameter: 12 in. to 26 ft., and 7 in. to 78 ft.
 WELL WATER TO BE USED AS:
 5 Public water supply 8 Air conditioning 11 Injection well
 1 Domestic 3 Feedlot 6 Oil field water supply 9 Dewatering 12 Other (Specify below)
 2 Irrigation 4 Industrial 7 Lawn and garden only 10 Monitoring well
 Was a chemical/bacteriological sample submitted to Department? Yes _____ No _____; If yes, mo/day/yr sample was submitted _____
 Water Well Disinfected? Yes No _____

5 TYPE OF BLANK CASING USED:
 1 Steel 3 RMP (SR) 5 Wrought iron 8 Concrete tile
 2 PVC 4 ABS 6 Asbestos-Cement 9 Other (specify below) SPR 26
 7 Fiberglass Casing Joints: Glued _____ Clamped _____
 Welded Threaded _____

Blank casing diameter: 5 in. to _____ ft. Dia. _____ in. to _____ ft. Dia. _____ in. to _____ ft.
 Casing height above land surface: 2 feet in., weight: 200 lbs./ft. Wall thickness or gauge No. 3.116

TYPE OF SCREEN OR PERFORATION MATERIAL:
 1 Steel 3 Stainless steel 5 Fiberglass 7 PVC 10 Asbestos-cement
 2 Brass 4 Galvanized steel 6 Concrete tile 8 RMP (SR) 11 Other (specify) SPR 26
 12 None used (open hole)

SCREEN OR PERFORATION OPENINGS ARE:
 1 Continuous slot 3 Mill slot 5 Gauzed wrapped 8 Saw cut 11 None (open hole)
 2 Louvered shutter 4 Key punched 6 Wire wrapped 9 Drilled holes

SCREEN-PERFORATED INTERVALS: top ft. to 33 pln ft. to 10 P.M. 20 R.F. ft. to 5 pln ft.
 From _____ ft. to _____ ft. From _____ ft. to _____ ft.
 GRAVEL PACK INTERVALS: From 13 ft. to 78 ft. From _____ ft. to _____ ft.

6 GROUT MATERIAL: 1/ Neat cement 2 Cement grout 3 Bentonite 4 Other _____
 Grout Intervals: From 3 ft. to 13 ft. From _____ ft. to _____ ft. From _____ ft. to _____ ft.

What is the nearest source of possible contamination:
 1 Septic tank 4 Lateral lines 7 Pit privy 10 Livestock pens 14 Abandoned water well
 2 Sewer lines 5 Cess pool 8 Sewage lagoon 11 Fuel storage 15 Oil well/Gas well
 3 Watertight sewer lines 6 Seepage pit 9 Feedyard 12 Fertilizer storage 16 Other (specify below)
 13 Insecticide storage
 Direction from well? N E How many feet? 200

FROM	TO	LITHOLOGIC LOG	FROM	TO	PLUGGING INTERVALS
top	4	top soil			
4	24	Brown clay			
24	27	sand Blue shale			
27	40	Blue shale			
40	43	Cracking Blue shale			
43	70	Blue shale			
70	73	gravel Blue shale			
73	78	Blue			

7 CONTRACTOR'S OR LANDOWNER'S CERTIFICATION: This water well was (1) constructed, (2) reconstructed, or (3) plugged under my jurisdiction and was completed on (mo/day/year) Mar 29 1990 and this record is true to the best of my knowledge and belief. Kansas Water Well Contractor's License No. 227 This Water Well Record was completed on (mo/day/yr) Mar 31 1990 under the business name of Frank Budde by (signature) Frank Budde