


1 LOCATION OF WATER WELL: Fraction SE 1/4 NW 1/4 SE 1/4 Section Number 16 Township Number T 23 S Range Number R 1 EW
 County: Haskell
 Distance and direction from nearest town or city street address of well if located within city? lots 9, 11, 13, 15 Block 7 Haskells Adcl

2 WATER WELL OWNER: Jimm ether
 RR#, St. Address, Box #: 1315 East 9th street
 City, State, ZIP Code: Newton Kansas
 Board of Agriculture, Division of Water Resources
 Application Number:

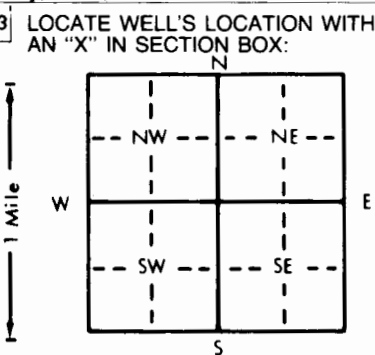

4 DEPTH OF COMPLETED WELL: 73 ft. ELEVATION:
 Depth(s) Groundwater Encountered 1. _____ ft. 2. _____ ft. 3. _____ ft.
 WELL'S STATIC WATER LEVEL 20 ft. below land surface measured on mo/day/yr May 20
 Pump test data: Well water was 55 ft. after 1 hours pumping 12 gpm
 Est. Yield 12 gpm: Well water was _____ ft. after _____ hours pumping _____ gpm
 Bore Hole Diameter 8 in. to 73 ft., and _____ in. to _____ ft.
 WELL WATER TO BE USED AS: 5 Public water supply 8 Air conditioning 11 Injection well
 1 Domestic 3 Feedlot 6 Oil field water supply 9 Dewatering 12 Other (Specify below)
 2 Irrigation 4 Industrial 7 Lawn and garden only 10 Monitoring well
 Was a chemical/bacteriological sample submitted to Department? Yes _____ No _____; If yes, mo/day/yr sample was submitted
 Water Well Disinfected? Yes X No

5 TYPE OF BLANK CASING USED: 5 Wrought iron 8 Concrete tile CASING JOINTS: Glued _____ Clamped _____
 1 Steel 3 RMP (SR) 6 Asbestos-Cement 9 Other (specify below) Welded X
 2 PVC 4 ABS 7 Fiberglass SPR26 Threaded _____
 Blank casing diameter 5 in. to 73 ft. Dia _____ in. to _____ ft. Dia _____ in. to _____ ft.
 Casing height above land surface 2 ft. in, weight 200 lbs./ft. Wall thickness or gauge No. 3/16
 TYPE OF SCREEN OR PERFORATION MATERIAL: 7 PVC 10 Asbestos-cement
 1 Steel 3 Stainless steel 5 Fiberglass 8 RMP (SR) 11 Other (specify) SPR26
 2 Brass 4 Galvanized steel 6 Concrete tile 9 ABS 12 None used (open hole)
 SCREEN OR PERFORATION OPENINGS ARE: 5 Gauzed wrapped 8 Saw cut X 11 None (open hole)
 1 Continuous slot 3 Mill slot 6 Wire wrapped 9 Drilled holes
 2 Louvered shutter 4 Key punched 7 Torch cut 10 Other (specify) _____
 SCREEN-PERFORATED INTERVALS: From 48 ft. to 68 ft., From _____ ft. to _____ ft.
 From _____ ft. to _____ ft., From _____ ft. to _____ ft.
 GRAVEL PACK INTERVALS: From 10 ft. to 73 ft., From _____ ft. to _____ ft.
 From _____ ft. to _____ ft., From _____ ft. to _____ ft.

6 GROUT MATERIAL: 1 Neat cement 2 Cement grout 3 Bentonite 4 Other _____
 Grout Intervals: From top ft. to 10 ft., From _____ ft. to _____ ft., From _____ ft. to _____ ft.
 What is the nearest source of possible contamination:
 1 Septic tank 4 Lateral lines 7 Pit privy 10 Livestock pens 14 Abandoned water well
 2 Sewer lines 5 Cess pool 8 Sewage lagoon 11 Fuel storage 15 Oil well/Gas well
 3 Watertight sewer lines 6 Seepage pit 9 Feedyard 12 Fertilizer storage 16 Other (specify below)
 13 Insecticide storage
 Direction from well? _____ How many feet? _____

| FROM | TO | LITHOLOGIC LOG | FROM | TO | PLUGGING INTERVALS |
|-----------|------------|--------------------------|------|----|--------------------|
| | <u>top</u> | <u>to 4</u> | | | |
| | | <u>top soil</u> | | | |
| | <u>4</u> | <u>60</u> | | | |
| | | <u>but Blue Shal</u> | | | |
| <u>40</u> | <u>63</u> | <u>gravel type shale</u> | | | |
| <u>43</u> | <u>73</u> | <u>Blue Shale</u> | | | |

7 CONTRACTOR'S OR LANDOWNER'S CERTIFICATION: This water well was (1) constructed, (2) reconstructed, or (3) plugged under my jurisdiction and was completed on (mo/day/year) May 24 and this record is true to the best of my knowledge and belief. Kansas Water Well Contractor's License No. 221 This Water Well Record was completed on (mo/day/yr) June 7 1991 under the business name of Frank Buckel by (signature) Frank Buckel

OFFICE USE ONLY
T
R
EW
SEC.