


USE TYPEWRITER OR BALL POINT PEN-PRESS FIRMLY, PRINT CLEARLY.

WATER WELL RECORD
KSA 82a-1201-1215

Kansas Department of Health and Environment-Division of Environment
(Water well Contractors)
Topeka, Kansas 66620

1. Location of well:	County HARVEY	Fraction SE 1/4 NW 1/4 NW 1/4	Section number 17	Township number T 23	Range number S R 1
----------------------	-------------------------	---	-----------------------------	--------------------------------	------------------------------

2. Distance and direction from nearest town or city:	3. Owner of well: MARK HAWK
Street address of well location if in city: 407 W 10TH	R.R. or street: 407 W 10TH
	City, state, zip code: NEWTON KS 67114

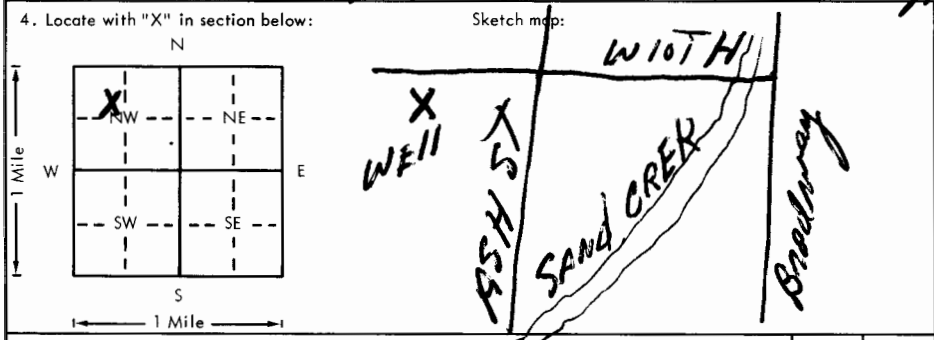

6. Bore hole dia. **10** in. Completion date **6-13-79**
Well depth **40** ft.

7. Cable tool Rotary Driven Dug
 Hollow rod Jetted Bored Reverse rotary

8. Use: Domestic Public supply Industry
 Irrigation Air conditioning Stock
 Lawn Oil field water Other

9. Casing: Material **PITS** Height: Above or below
Threaded Welded Surface **18** in.
RMP PVC Weight **1-50** lbs./ft.
Dia. **3** in. to **40** ft. depth Wall Thickness: inches or
Dia. in. to ft. depth gage No. **200**

5. Type and color of material	From	To
TOP SOIL	0	2
SANDY CLAY	2	10
SAND FINE BLACK	10	20
SAND FINE TO COARSE BLACK	20	30
SHALE BLACK	30	40

10. Screen: Manufacturer's name **SURMAC**
Type **RMP** Dia. **3**
Slot/gauze **.005** Length **20**
Set between **20** ft. and **40** ft.
Gravel pack? **YES** Size range of material **1/4-1/8**

11. Static water level: **10** ft. below land surface Date **6-13-79**
mo./day/yr.

12. Pumping level below land surfaces:
20 ft. after **1** hrs. pumping **12** g.p.m.
ft. after hrs. pumping g.p.m.
Estimated maximum yield **12** g.p.m.

13. Water sample submitted: Yes No Date

14. Well head completion: **18** inches above grade
 Pitless adapter

15. Well grouted? **YES**
With: Neat cement Bentonite Concrete
Depth: From **0** ft. to **10** ft.

16. Nearest source of possible contamination: **SEWER**
ft. **60** Direction **N** Type **MAIN**
Well disinfected upon completion? Yes No

17. Pump: Not installed
Manufacturer's name _____
Model number _____ HP _____ Volts _____
Length of drop pipe _____ ft. capacity _____ g.p.m.
Type:
 Submersible Turbine
 Jet Reciprocating
 Centrifugal Other

18. Elevation:

Topography:
 Hill
 Slope
 Upland
 Valley

19. Remarks:

20. Water well contractor's certification:
This well was drilled under my jurisdiction and this report is true to the best of my knowledge and belief.
PAR Well Service 211
Business name _____ License No. _____
Address **407 Broadway Newton, Kan**
Signature **W. J. Williams** Date **7-5-79**
Authorized representative

T 23 R 10 SE NW 1/4 17