


1 LOCATION OF WATER WELL: Position NW 1/4 - SE 1/4 NW 1/4 Section Number 17 Township Number T 23 N Range Number R 3 E
 County: Harvey Newton City Lots 20 22 1/2 Block 80 Newton

Distance and direction from nearest town or city street address of well if located within city?
418 E. 3rd St. Newton, Kansas 67114

2 WATER WELL OWNER: John H. Schmidt
 RR#, St. Address, Box #: 418 E. 3rd St.
 City, State, ZIP Code: Newton, Kansas 67114
 Board of Agriculture, Division of Water Resources
 Application Number: 7

3 LOCATE WELL'S LOCATION WITH AN "X" IN SECTION BOX:

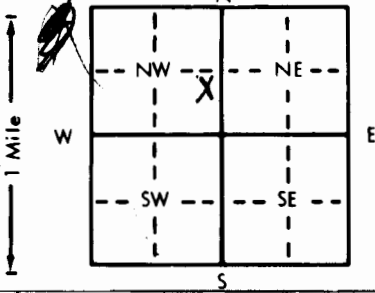

4 DEPTH OF COMPLETED WELL... 72 ft. ELEVATION: 72 ft.

Depth(s) Groundwater Encountered 1. 16 ft. 2. 40 ft. 3. 60 ft.

WELL'S STATIC WATER LEVEL 13 1/2 ft. below land surface measured on mo/day/yr July 6th, 1981

Pump test data: Well water was 20 ft. after 10 hours pumping 6 gpm

Est. Yield 10 gpm: Well water was ? ft. after 1/2 hours pumping ? gpm

Bore Hole Diameter 6 1/2 in. to 7 1/2 in. and Bottom in. to ? in.

WELL WATER TO BE USED AS: 5 Public water supply 8 Air conditioning? 11 Injection well
 1 Domestic 3 Feedlot 6 Oil field water supply 9 Dewatering 12 Other (Specify below)

Was a chemical/bacteriological sample submitted to Department? Yes ? No X; If yes, mo/day/yr sample was submitted

5 TYPE OF BLANK CASING USED: 5 Wrought iron 8 Concrete tile CASING JOINTS: Glued X Clamped X

Blank casing diameter 5 in. to 7 1/2 in. Dia Bottom in. to ? in. to ? in. to ? in.

Casing height above land surface 16 in., weight ? lbs./ft. Wall thickness or gauge No. ?

TYPE OF SCREEN OR PERFORATION MATERIAL: 7 PVC 10 Asbestos-cement

SCREEN OR PERFORATION OPENINGS ARE: 5 Gauzed wrapped 8 Saw cut 11 None (open hole)

SCREEN-PERFORATED INTERVALS: From 31 down ft. to for 40 ft., From to bottom ft. to ? ft.

GRAVEL PACK INTERVALS: From 10 ft. to bottom ft., From ? ft. to ? ft.

6 GROUT MATERIAL: 1 Neat cement 2 Cement grout 3 Bentonite 4 Other ?

Grout intervals: From top ft. to 10 ft., From ? ft. to ? ft., From ? ft. to ? ft.

What is the nearest source of possible contamination: 10 Livestock pens 14 Abandoned water well

Direction from well? west How many feet? 20

FROM TO LITHOLOGIC LOG FROM TO LITHOLOGIC LOG

1 3 Black top soil

3 25 White clay

25 28 Changing color to gray

28 40 grey

40 71 Dark clay and shale

and heating & air conditioning later on X

7 CONTRACTOR'S OR LANDOWNER'S CERTIFICATION: This water well was (1) constructed, (2) reconstructed, or (3) plugged under my jurisdiction and was completed on (mo/day/year) July 6, 1981 and this record is true to the best of my knowledge and belief. Kansas Water Well Contractor's License No. 390 This Water Well Record was completed on (mo/day/yr) July 30, 1981

under the business name of Home Water Well Drilling by (signature) [Signature]

INSTRUCTIONS: Use typewriter or ball point pen, PLEASE PRESS FIRMLY and PRINT clearly. Please fill in blanks, underline or circle the correct answers. Send top three copies to Kansas Department of Health and Environment, Division of Environment, Environmental Geology Section, Topeka, KS 66620. Send one to WATER WELL OWNER and retain one for your records.

OFFICE USE ONLY

T

23

H

DBW

SEC. 17

NE 1/4 SE 1/4 NW 1/4