


1 LOCATION OF WATER WELL: County: HARVEY Fraction: NE 1/4 NE 1/4 SW 1/4 Section Number: 17 Township Number: T 03 S Range Number: R 1 EW

Distance and direction from nearest town or city street address of well if located within city? 5th + POPLAR NK-MWI

2 WATER WELL OWNER: CONTINENTAL BAKING CO RR#, St. Address, Box #: 111 S SHERIDAN PO 906059 Board of Agriculture, Division of Water Resources City, State, ZIP Code: NEWTON KS TULSA OK 74112 Application Number:

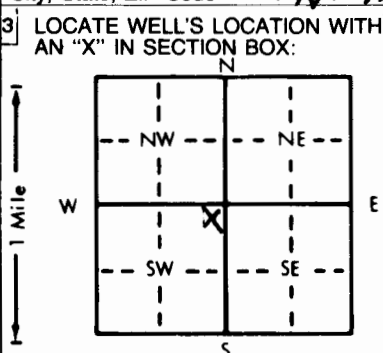

3 LOCATE WELL'S LOCATION WITH AN 'X' IN SECTION BOX: 4 DEPTH OF COMPLETED WELL: 14 ft. ELEVATION: WELL'S STATIC WATER LEVEL: 8.2 ft. below land surface measured on mo/day/yr

5 TYPE OF BLANK CASING USED: 1 Steel, 2 PVC, 3 RMP (SR), 4 ABS, 5 Wrought iron, 6 Asbestos-Cement, 7 Fiberglass, 8 Concrete tile, 9 Other (specify below), 10 Monitoring well, CASING JOINTS: Glued, Clamped, Welded, Threaded

Blank casing diameter: 2 in. to 9 ft., Dia. in. to ft., Dia. in. to ft. Casing height above land surface: in., weight lbs./ft. Wall thickness or gauge No.

TYPE OF SCREEN OR PERFORATION MATERIAL: 1 Steel, 2 Brass, 3 Stainless steel, 4 Galvanized steel, 5 Fiberglass, 6 Concrete tile, 7 PVC, 8 RMP (SR), 9 ABS, 10 Asbestos-cement, 11 Other (specify), 12 None used (open hole)

SCREEN OR PERFORATION OPENINGS ARE: 1 Continuous slot, 2 Louvered shutter, 3 Mill slot, 4 Key punched, 5 Gauzed wrapped, 6 Wire wrapped, 7 Torch cut, 8 Saw cut, 9 Drilled holes, 10 Other (specify), 11 None (open hole)

SCREEN-PERFORATED INTERVALS: From 9 ft. to 14 ft., From 8 ft. to 14 ft., GRAVEL PACK INTERVALS: From 8 ft. to 14 ft., From ft. to ft.

6 GROUT MATERIAL: 1 Neat cement, 2 Cement grout, 3 Bentonite, 4 Other, Grout Intervals: From 0 ft. to 8 ft., From ft. to ft., From ft. to ft.

What is the nearest source of possible contamination: 1 Septic tank, 2 Sewer lines, 3 Watertight sewer lines, 4 Lateral lines, 5 Cess pool, 6 Seepage pit, 7 Pit privy, 8 Sewage lagoon, 9 Feedyard, 10 Livestock pens, 11 Fuel storage, 12 Fertilizer storage, 13 Insecticide storage, 14 Abandoned water well, 15 Oil well/Gas well, 16 Other (specify below)

Direction from well? WITHIN FACILITY How many feet?

Table with columns: FROM, TO, LITHOLOGIC LOG, FROM, TO, PLUGGING INTERVALS. Entry: 0 TO SILTY CLAY

7 CONTRACTOR'S OR LANDOWNER'S CERTIFICATION: This water well was (1) constructed, (2) reconstructed, or (3) plugged under my jurisdiction and was completed on (mo/day/year) 2/7/92 and this record is true to the best of my knowledge and belief. Kansas Water Well Contractor's License No. 102 This Water Well Record was completed on (mo/day/yr) 3/3/92 under the business name of Flame Wessler Co Wichita by (signature)