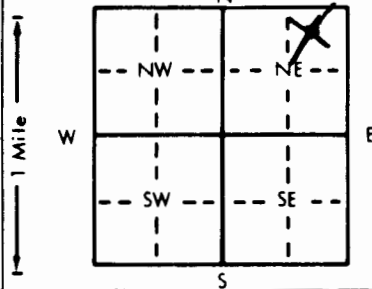


1 LOCATION OF WATER WELL: Fraction NW 1/4 NW 1/4 NW 1/4 Section Number 118 Township Number T 23 S Range Number R 1 E  
 County: Harvey

Distance and direction from nearest town or city street address of well if located within city?  
In city limits-1500 N. Plum

2 WATER WELL OWNER: Melvin Wedel  
 RR#, St. Address, Box # : 1500 N. Plum Board of Agriculture, Division of Water Resources  
 City, State, ZIP Code : Newton, KS 67114 Application Number:

3 LOCATE WELL'S LOCATION WITH AN "X" IN SECTION BOX:  


4 DEPTH OF COMPLETED WELL... 37 ft. ELEVATION:  
 Depth(s) Groundwater Encountered 1... 12 ft. 2... ft. 3... ft.  
 WELL'S STATIC WATER LEVEL ... 12 ft. below land surface measured on mo/day/yr ... 6-3-93  
 Pump test data: Well water was ... ft. after ... hours pumping ... gpm  
 Est. Yield ... 1.0 gpm: Well water was ... 1.6 ft. after ... 1 hours pumping ... 8 gpm  
 Bore Hole Diameter ... 8 in. to ... 40 ft., and ... in. to ... ft.  
 WELL WATER TO BE USED AS:  
 5 Public water supply 8 Air conditioning 11 Injection well  
 1 Domestic 3 Feedlot 6 Oil field water supply 9 Dewatering 12 Other (Specify below)  
 2 Irrigation 4 Industrial 7 Lawn and garden only 10 Monitoring well  
 Was a chemical/bacteriological sample submitted to Department? Yes... No... X...; If yes, mo/day/yr sample was submitted  
 Water Well Disinfected? Yes X No

5 TYPE OF BLANK CASING USED:  
 1 Steel 3 RMP (SR) 5 Wrought iron 8 Concrete tile CASING JOINTS: Glued X Clamped  
 2 PVC 4 ABS 6 Asbestos-Cement 9 Other (specify below) Welded  
 7 Fiberglass Threaded  
 Blank casing diameter ... 5 in. to ... 27 ft., Dia ... in. to ... ft., Dia ... in. to ... ft.  
 Casing height above land surface ... 12 in., weight ... 2.37 lbs./ft. Wall thickness or gauge No. ... 214  
 TYPE OF SCREEN OR PERFORATION MATERIAL:  
 1 Steel 3 Stainless steel 5 Fiberglass 7 PVC 10 Asbestos-cement  
 2 Brass 4 Galvanized steel 6 Concrete tile 8 RMP (SR) 11 Other (specify)  
 9 ABS 12 None used (open hole)  
 SCREEN OR PERFORATION OPENINGS ARE:  
 1 Continuous slot 3 Mill slot 5 Gauzed wrapped 8 Saw cut 11 None (open hole)  
 2 Louvered shutter 4 Key punched 6 Wire wrapped 9 Drilled holes  
 7 Torch cut 10 Other (specify)  
 SCREEN-PERFORATED INTERVALS: From ... 27 ft. to ... 37 ft., From ... ft. to ... ft.  
 GRAVEL PACK INTERVALS: From ... 25 ft. to ... 37 ft., From ... ft. to ... ft.

6 GROUT MATERIAL: 1 Neat cement 2 Cement grout 3 Bentonite 4 Other  
 Grout Intervals: From ... 5 ft. to ... 25 ft., From ... ft. to ... ft., From ... ft. to ... ft.  
 What is the nearest source of possible contamination:  
 1 Septic tank 4 Lateral lines 7 Pit privy 10 Livestock pens 14 Abandoned water well  
 2 Sewer lines 5 Cess pool 8 Sewage lagoon 11 Fuel storage 15 Oil well/Gas well  
 3 Watertight sewer lines 6 Seepage pit 9 Feedyard 12 Fertilizer storage 16 Other (specify below)  
 13 Insecticide storage  
 Direction from well? West How many feet? 75 ft

FROM	TO	LITHOLOGIC LOG	FROM	TO	PLUGGING INTERVALS
0	1	Top Soil			
1	4	Tan Clay			
4	6	Top Soil			
6	25	Tan Clay			
25	34	Fine Sand			
34	40	Green Shale			

7 CONTRACTOR'S OR LANDOWNER'S CERTIFICATION: This water well was (1) constructed, (2) reconstructed, or (3) plugged under my jurisdiction and was completed on (mo/day/year) ... 6-3-93 ... and this record is true to the best of my knowledge and belief. Kansas Water Well Contractor's License No. ... 138 ... This Water Well Record was completed on (mo/day/yr) ... 6-8-93 ... under the business name of Peterson Irrigation Inc. by (signature) Mike Peterson