


1 LOCATION OF WATER WELL: County: Haskell Fraction: N 1/4 W 1/4 Section Number: 18 Township Number: T 23 S Range Number: R 1 E/W
 Distance and direction from nearest town or city street address of well if located within city?

2 WATER WELL OWNER: Donovan & Ursula corner Lot
 RR#, St. Address, Box #: 1236 W Columbus circle Board of Agriculture, Division of Water Resources
 City, State, ZIP Code: Newton Kansas Application Number:

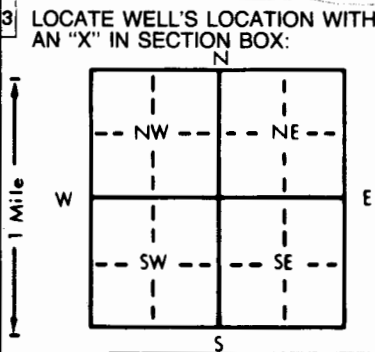

4 DEPTH OF COMPLETED WELL: 71 ft. ELEVATION:
 Depth(s) Groundwater Encountered 1. _____ ft. 2. _____ ft. 3. _____ ft.
 WELL'S STATIC WATER LEVEL: 20 ft. below land surface measured on mo/day/yr Aug 2 1990
 Pump test data: Well water was 30 ft. after 1 hours pumping _____ gpm
 Est. Yield 12 gpm: Well water was 30 ft. after _____ hours pumping _____ gpm
 Bore Hole Diameter: 5 in. to 7 1/2 in. to _____ in. to _____ in. to _____ ft.
 WELL WATER TO BE USED AS:
 5 Public water supply 8 Air conditioning 11 Injection well
 1 Domestic 3 Feedlot 6 Oil field water supply 9 Dewatering 12 Other (Specify below)
 2 Irrigation 4 Industrial 7 Lawn and garden only 10 Monitoring well
 Was a chemical/bacteriological sample submitted to Department? Yes _____ No _____; If yes, mo/day/yr sample was submitted
 Water Well Disinfected? Yes X No

5 TYPE OF BLANK CASING USED:
 1 Steel 3 RMP (SR) 5 Wrought iron 8 Concrete tile CASING JOINTS: Glued _____ Clamped _____
 2 PVC 4 ABS 6 Asbestos-Cement 9 Other (specify below) Welded X
 7 Fiberglass SDR 26 Threaded _____
 Blank casing diameter: 5 in. to 7 1/2 ft., Dia _____ in. to _____ ft., Dia _____ in. to _____ ft.
 Casing height above land surface: 18 in., weight 200 lbs./ft. Wall thickness or gauge No. 3/16
 TYPE OF SCREEN OR PERFORATION MATERIAL:
 1 Steel 3 Stainless steel 5 Fiberglass 7 PVC 10 Asbestos-cement
 2 Brass 4 Galvanized steel 6 Concrete tile 8 RMP (SR) 11 Other (specify) SDR 26
 9 ABS 12 None used (open hole)
 SCREEN OR PERFORATION OPENINGS ARE:
 1 Continuous slot 3 Mill slot 5 Gauzed wrapped 8 Saw cut X 11 None (open hole)
 2 Louvered shutter 4 Key punched 6 Wire wrapped 9 Drilled holes
 7 Torch cut 10 Other (specify)
 SCREEN-PERFORATED INTERVALS: From 20 ft. to 30 ft., From 47 ft. to 67 ft.
 GRAVEL PACK INTERVALS: From _____ ft. to 10 ft., From 71 ft. to _____ ft.

6 GROUT MATERIAL: 1 Neat cement 2 Cement grout 3 Bentonite 4 Other
 Grout Intervals: From top ft. to 10 ft., From _____ ft. to _____ ft., From _____ ft. to _____ ft.
 What is the nearest source of possible contamination:
 1 Septic tank 4 Lateral lines 7 Pit privy 10 Livestock pens 14 Abandoned water well
 2 Sewer lines 5 Cess pool 8 Sewage lagoon 11 Fuel storage 15 Oil well/Gas well
 3 Watertight sewer lines 6 Seepage pit 9 Feedyard 12 Fertilizer storage 16 Other (specify below)
 13 Insecticide storage
 Direction from well? 200 How many feet? W creek

FROM	TO	LITHOLOGIC LOG	FROM	TO	PLUGGING INTERVALS
	<u>4</u>	<u>top soil</u>		<u>60</u>	
<u>4</u>	<u>10</u>	<u>Brown clay</u>	<u>60</u>	<u>64</u>	<u>sand Blue clay</u>
<u>10</u>	<u>20</u>	<u>Blue shale</u>	<u>64</u>	<u>71</u>	<u>Blue clay</u>
<u>20</u>	<u>22</u>	<u>sand type shale</u>			
<u>22</u>	<u>40</u>	<u>Blue clay</u>			
<u>40</u>	<u>41</u>	<u>limestone</u>			
<u>41</u>	<u>60</u>	<u>Blue shale</u>			

7 CONTRACTOR'S OR LANDOWNER'S CERTIFICATION: This water well was (1) constructed, (2) reconstructed, or (3) plugged under my jurisdiction and was completed on (mo/day/year) Aug 4 and this record is true to the best of my knowledge and belief. Kansas Water Well Contractor's License No. _____ This Water Well Record was completed on (mo/day/yr) May 16 1990 under the business name of 221 by (signature) Terrence Budde

OFFICE USE ONLY
T
R
EW
SEC.
1/4
1/4
1/4