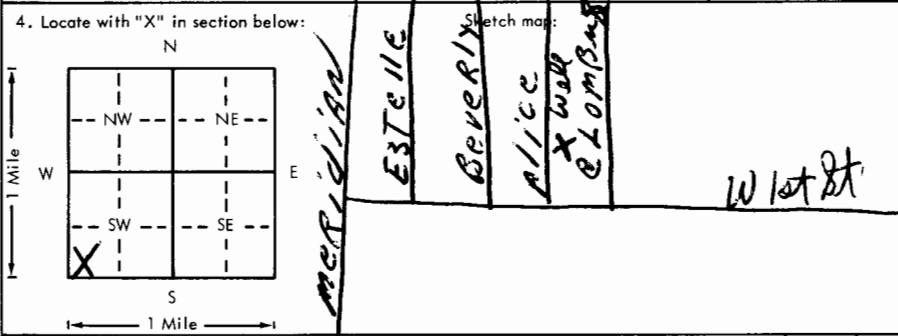


USE TYPEWRITER OR BALL
POINT PEN-PRESS FIRMLY,
PRINT CLEARLY.

WATER WELL RECORD
KSA 82a-1201-1215

Kansas Department of Health and
Environment-Division of Environment
(Water well Contractors)
Topeka, Kansas 66620

1. Location of well:		County HARVEY	Fraction SW 1/4 SW 1/4 SW 1/4	Section number 18	Township number T 23 S R 1	Range number 1
2. Distance and direction from nearest town or city: Street address of well location if in city: 209 Columbus				3. Owner of well: W. J. McKibben R.R. or street: 209 Columbus City, state, zip code: Newton KS 67114		
4. Locate with "X" in section below: 				6. Bore hole dia. 10 in. Completion date 11-25-77 Well depth 55 ft.		
5. Type and color of material				7. <input type="checkbox"/> Cable tool <input checked="" type="checkbox"/> Rotary <input type="checkbox"/> Driven <input type="checkbox"/> Dug <input type="checkbox"/> Hollow rod <input type="checkbox"/> Jetted <input type="checkbox"/> Bored <input type="checkbox"/> Reverse rotary		
				8. Use: <input type="checkbox"/> Domestic <input type="checkbox"/> Public supply <input type="checkbox"/> Industry <input checked="" type="checkbox"/> Irrigation <input type="checkbox"/> Air conditioning <input type="checkbox"/> Stock <input type="checkbox"/> Lawn <input type="checkbox"/> Oil field water <input type="checkbox"/> Other		
				9. Casing: Material PITS Height: 9 ft. Threaded <input type="checkbox"/> Welded <input type="checkbox"/> Surface 78 in. RMP <input checked="" type="checkbox"/> PVC <input type="checkbox"/> Weight 1.50 lbs./ft. Dia. 5 in. to 55 ft. depth Wall Thickness: inches or Dia. <input type="checkbox"/> in. to <input type="checkbox"/> ft. depth gage No. 200		
				10. Screen: Manufacturer's name J & L Type RMP Dia. 5 Slot/gauze .06 Length 30 Set between 25 ft. and 55 ft. Gravel pack? <input checked="" type="checkbox"/> Size range of material 28		
				11. Static water level: 18 ft. below land surface Date 11-25-77 12. Pumping level below land surfaces: 25 ft. after 2 hrs. pumping 17 g.p.m. ____ ft. after ____ hrs. pumping ____ g.p.m. Estimated maximum yield 30 g.p.m.		
				13. Water sample submitted: ____ mo./day/yr. Yes <input checked="" type="checkbox"/> No <input type="checkbox"/> Date ____		
				14. Well head completion: NO Pitless adapter ____ Inches above grade		
				15. Well grouted? yes With: <input checked="" type="checkbox"/> Neat cement <input type="checkbox"/> Bentonite <input type="checkbox"/> Concrete Depth: From 0 ft. to 10 ft.		
				16. Nearest source of possible contamination: CITY ft. 50 Direction W Type sewer Well disinfected upon completion? <input checked="" type="checkbox"/> Yes <input type="checkbox"/> No		
				17. Pump: ____ Not installed Manufacturer's name PUMP CO Model number ____ HP 1/2 Vol 230 Length of drop pipe 45 ft. capacity 15 g.p.m. Type: <input checked="" type="checkbox"/> Submersible <input type="checkbox"/> Turbine <input type="checkbox"/> Jet <input type="checkbox"/> Reciprocating <input type="checkbox"/> Centrifugal <input type="checkbox"/> Other		
(Use a second sheet if needed)						
18. Elevation:		19. Remarks:		20. Water well contractor's certification: This well was drilled under my jurisdiction and this report is true to the best of my knowledge and belief. W. J. McKibben 211 Business name License No. Address 428 W 3rd Newton KS Signed W. J. McKibben Date 1-8-78 Authorized representative		