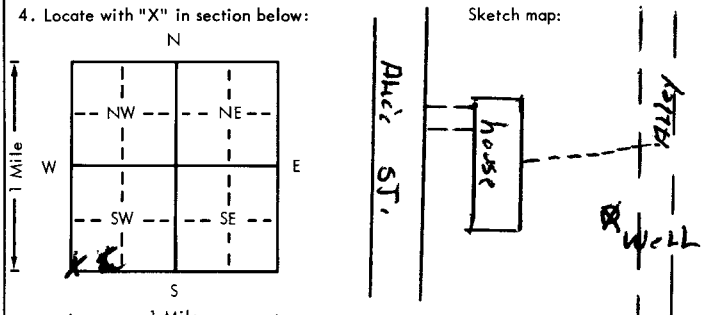


USE TYPEWRITER OR BALL POINT PEN—PRESS FIRMLY, PRINT CLEARLY.

WATER WELL RECORD
KSA 82a-1201-1215

Kansas Department of Health and Environment—Division of Environment
(Water well Contractors)
Topeka, Kansas 66620

1. Location of well:	County HARVEY	Fraction SW 1/4 SW 1/4 SW 1/4	Section number 18	Township number T 23	Range number S R 1 EW
2. Distance and direction from nearest town or city: Street address of well location if in city: 112 Alice St - Newton			3. Owner of well: Wellbert Witzke R.R. or street: 112 Alice St City, state, zip code: Newton, Kansas 67114		
4. Locate with "X" in section below: 			6. Bore hole dia. 10 in. Completion date 3/19/27 Well depth _____ ft.		
5. Type and color of material			7. <input type="checkbox"/> Cable tool <input checked="" type="checkbox"/> Rotary <input type="checkbox"/> Driven <input type="checkbox"/> Dug <input type="checkbox"/> Hollow rod <input type="checkbox"/> Jetted <input type="checkbox"/> Bored <input type="checkbox"/> Reverse rotary		
			8. Use: <input type="checkbox"/> Domestic <input type="checkbox"/> Public supply <input type="checkbox"/> Industry <input type="checkbox"/> Irrigation <input type="checkbox"/> Air conditioning <input type="checkbox"/> Stock <input checked="" type="checkbox"/> Lawn <input type="checkbox"/> Oil field water <input type="checkbox"/> Other		
From To			9. Casing: Material Plastic Height Above or below Threaded _____ Welded <input checked="" type="checkbox"/> Surface 12 in. RMP _____ PVC <input checked="" type="checkbox"/> Weight 2.28 lbs./ft. Dia. 5 in. to 46 ft. depth Wall Thickness: inches or Dia. _____ in. to _____ ft. depth Gage No. 2225		
			10. Screen: Manufacturer's name Rabin-Tech - own slot Type PVC Dia. 5" Slot/gauze 046 Length 20' Set between _____ ft. and _____ ft. 26 ft. and 46 ft. Gravel pack? <input checked="" type="checkbox"/> Size range of material 48-1/4		
Lamin to red clay			11. Static water level: _____ mo./day/yr. 16 ft. below land surface Date 3/19/27		
Red clay			12. Pumping level below land surfaces: _____ ft. after _____ hrs. pumping _____ g.p.m. 32' ft. after 1 hrs. pumping 20 g.p.m. Estimated maximum yield 20/25 g.p.m.		
Red clay to brown			13. Water sample submitted: _____ mo./day/yr. <input type="checkbox"/> Yes <input checked="" type="checkbox"/> No Date _____		
Light brown clay			14. Well head completion: <input type="checkbox"/> Pitless adapter 12 Inches above grade		
Light grey clay			15. Well grouted? NO With: <input type="checkbox"/> Neat cement <input type="checkbox"/> Bentonite <input type="checkbox"/> Concrete Depth: From _____ ft. to _____ ft.		
Grey - brown clay - sandy			16. Nearest source of possible contamination: ft. 35 Direction EAST Type Sewer Well disinfected upon completion? <input type="checkbox"/> Yes <input checked="" type="checkbox"/> No		
Grey clay & coarse sand - mix			17. Pump: <input checked="" type="checkbox"/> Not installed Manufacturer's name _____ Model number _____ HP _____ Volts _____ Length of drop pipe _____ ft. capacity _____ g.p.m. Type: <input type="checkbox"/> Submersible <input type="checkbox"/> Turbine <input type="checkbox"/> Jet <input type="checkbox"/> Reciprocating <input type="checkbox"/> Centrifugal <input type="checkbox"/> Other		
Sand - sharp w/ clay nodules			(Use a second sheet if needed)		
green - grey shale					
Webbington shale			20. Water well contractor's certification: This well was drilled under my jurisdiction and this report is true to the best of my knowledge and belief. PAUL'S INC #175 Business name License No. Address Box 26 Newton, Kns Signed Paul Buchheit Date 3/19/27 Authorized Representative		
18. Elevation:		19. Remarks: owner to grout well with neat cement			
Topography: <input type="checkbox"/> Hill <input checked="" type="checkbox"/> Slope <input type="checkbox"/> Upland <input type="checkbox"/> Valley					

T 23
 R 10
 W 18
 Sec SW SE SW
 1/4 1/4 1/4

Forward the white, blue and pink copies to the Department of Health and Environment

Form WWC-5