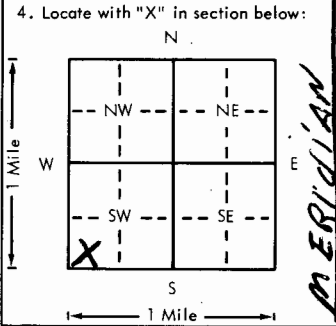


USE TYPEWRITER OR BALL
POINT PEN-PRESS FIRMLY,
PRINT CLEARLY.

WATER WELL RECORD
KSA 82a-1201-1215

Kansas Department of Health and
Environment-Division of Environment
(Water well Contractors)
Topeka, Kansas 66620

1. Location of well:		County HARVEY	Fraction SW 1/4 SW 1/4 SW 1/4	Section number 18	Township number T 23 S R 1	Range number 1
2. Distance and direction from nearest town or city: Street address of well location if in city: 120 Alice			3. Owner of well: Fred McChase R.R. or street: 120 ALICE City, state, zip code: NEWTON KS 67114			
4. Locate with "X" in section below: 			6. Bore hole dia. 10 in. Completion date 11-21-77 Well depth 50 ft.			
			7. <input checked="" type="checkbox"/> Cable tool <input checked="" type="checkbox"/> Rotary <input type="checkbox"/> Driven <input type="checkbox"/> Dug <input type="checkbox"/> Hollow rod <input type="checkbox"/> Jetted <input type="checkbox"/> Bored <input type="checkbox"/> Reverse rotary			
			8. Use: <input type="checkbox"/> Domestic <input type="checkbox"/> Public supply <input type="checkbox"/> Industry <input checked="" type="checkbox"/> Irrigation <input type="checkbox"/> Air conditioning <input type="checkbox"/> Stock <input type="checkbox"/> Lawn <input type="checkbox"/> Oil field water <input type="checkbox"/> Other			
			9. Casing: Material PITS Height Above 18 ft. below Threaded <input type="checkbox"/> Welded <input type="checkbox"/> Surface <input type="checkbox"/> in. RMP <input checked="" type="checkbox"/> PVC <input type="checkbox"/> Weight 1.50 lbs./ft. Dia. 5 in. to 50 ft. depth Wall Thickness: inches or Dia. 5 in. to 50 ft. depth gage No. 200			
5. Type and color of material			From	To	10. Screen: Manufacturer's name J & Z	
TOP SOIL			0	3	Type RMP Dia. 5	
CLAY SANDY			3	20	Slot/gauze 26 Length 30	
SAND FINE			20	30	Set between 20 ft. and 50 ft.	
SAND FINE TO COARSE			30	40	Gravel pack? <input checked="" type="checkbox"/> Size range of material 28	
SHALE GRAY			40	50	11. Static water level: 18 ft. below land surface Date 11-21-77	
					12. Pumping level below land surfaces: 25 ft. after 2 hrs. pumping 17 g.p.m. ft. after hrs. pumping g.p.m. Estimated maximum yield 30 g.p.m.	
					13. Water sample submitted: <input checked="" type="checkbox"/> Yes <input type="checkbox"/> No Date	
					14. Well head completion: NO Pitless adapter <input type="checkbox"/> Inches above grade	
					15. Well grouted? yes With: <input checked="" type="checkbox"/> Neat cement <input type="checkbox"/> Bentonite <input type="checkbox"/> Concrete Depth: From 0 ft. to 10 ft.	
					16. Nearest source of possible contamination: ft. 50 Direction E Type CITY SEWER Well disinfected upon completion? <input checked="" type="checkbox"/> Yes <input type="checkbox"/> No	
					17. Pump: Manufacturer's name Pumpco Not installed Model number 40 HP 1/2 Volts 230 Length of drop pipe 40 ft. capacity 15 g.p.m. Type: <input checked="" type="checkbox"/> Submersible <input type="checkbox"/> Turbine <input type="checkbox"/> Jet <input type="checkbox"/> Reciprocating <input type="checkbox"/> Centrifugal <input type="checkbox"/> Other	
18. Elevation:			(Use a second sheet if needed)		20. Water well contractor's certification: This well was drilled under my jurisdiction and this report is true to the best of my knowledge and belief. D & R Well Service 211 Business name 4284 3rd Newton, KS 67114 License No. 1-5-78 Address W. Williams Date 1-5-78 Signed W. Williams Authorized representative	
19. Remarks:						