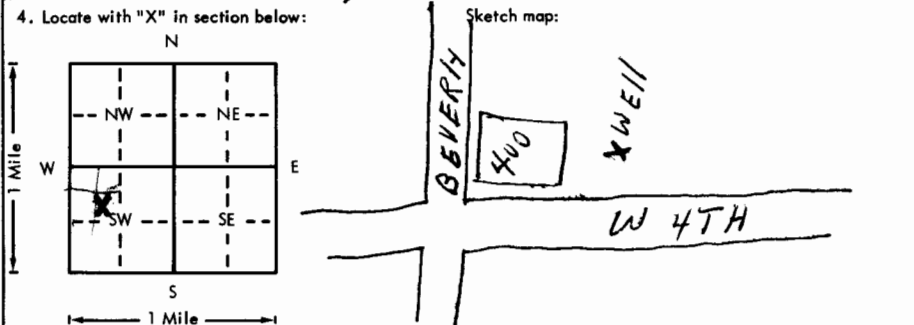


USE TYPEWRITER OR BALL POINT PEN-PRESS FIRMLY, PRINT CLEARLY.

WATER WELL RECORD  
KSA 82a-1201-1215

Kansas Department of Health and Environment-Division of Environment (Water well Contractors) Topeka, Kansas 66620

|   |              |
|---|--------------|
| 1. Location of well: County <b>HARVEY</b> Fraction <b>SE 1/4 NW 1/4 SW 1/4</b> Section number <b>18</b> Township number <b>T 23 S</b> Range number <b>R 1 E</b>   |              |
| 2. Distance and direction from nearest town or city: Street address of well location if in city: <b>400 BEVERLY</b>   |              |
| 3. Owner of well: <b>GENE MSCHOFF</b><br>R.R. or street: <b>400 BEVERLY</b><br>City, state, zip code: <b>NEWTON KANSAS 67114</b>  |              |
| 4. Locate with "X" in section below:<br>   |              |
| 5. Type and color of material   |              |
|   | From To      |
| <b>TOP SOIL</b>   | 0 3          |
| <b>CLAY RED</b>   | 3 25         |
| <b>CLAY SANDY</b>   | 25 35        |
| <b>SAND FINE TO COARSE</b>  | 35 50        |
| (Use a second sheet if needed)  |              |
| 18. Elevation:<br><br>Topography:<br>___ Hill<br>___ Slope<br>___ Upland<br>___ Valley  | 19. Remarks: |
| 6. Bore hole dia. <b>10</b> in. Completion date <b>8-23-77</b><br>Well depth <b>50</b> ft.  |              |
| 7. ___ Cable tool ___ Rotary ___ Driven ___ Dug<br>___ Hollow rod ___ Jetted ___ Bored ___ Reverse rotary   |              |
| 8. Use: ___ Domestic ___ Public supply ___ Industry<br>___ Irrigation ___ Air conditioning ___ Stock<br><input checked="" type="checkbox"/> Lawn ___ Oil field water ___ Other  |              |
| 9. Casing: Material <b>PITS</b> Height: Above or below<br>Threaded ___ Welded ___ Surface <b>18</b> in.<br>RMP <input checked="" type="checkbox"/> PVC ___ Weight <b>1.50</b> lbs./ft.<br>Dia. <b>5</b> in. to <b>50</b> ft. depth Wall Thickness: inches or<br>Dia. ___ in. to ___ ft. depth gage No. <b>200</b>   |              |
| 10. Screen: Manufacturer's name <b>J &amp; J</b><br>Type <b>RMP</b> Dia. <b>5</b><br>Slot/gauze <b>0.26</b> Length <b>30</b><br>Set between <b>20</b> ft. and <b>50</b> ft.<br>Gravel pack? <b>YES</b> Size range of material <b>10-14</b>  |              |
| 11. Static water level: <b>20</b> ft. below land surface Date <b>8-23-77</b> mo./day/yr.  |              |
| 12. Pumping level below land surfaces:<br><b>25</b> ft. after <b>1</b> hrs. pumping <b>20</b> g.p.m.<br>___ ft. after ___ hrs. pumping ___ g.p.m.<br>Estimated maximum yield <b>20-30</b> g.p.m.  |              |
| 13. Water sample submitted: ___ Yes <input checked="" type="checkbox"/> No Date ___ mo./day/yr.   |              |
| 14. Well head completion: <b>NO</b> Pitless adapter <b>18</b> Inches above grade  |              |
| 15. Well grouted? <b>YES</b><br>With: <input checked="" type="checkbox"/> Neat cement ___ Bentonite ___ Concrete<br>Depth: From <b>0</b> ft. to <b>10</b> ft.   |              |
| 16. Nearest source of possible contamination: <b>SEWER</b><br>ft. <b>30</b> Direction <b>E</b> Type <b>SEWER</b><br>Well disinfected upon completion? <input checked="" type="checkbox"/> Yes ___ No  |              |
| 17. Pump: ___ Not installed<br>Manufacturer's name <b>PUMP CO</b><br>Model number ___ HP <b>1/2</b> Volts <b>230</b><br>Length of drop pipe <b>40</b> ft. capacity <b>15</b> g.p.m.<br>Type:<br><input checked="" type="checkbox"/> Submersible ___ Turbine<br>___ Jet ___ Reciprocating<br>___ Centrifugal ___ Other   |              |
| 20. Water well contractor's certification:<br>This well was drilled under my jurisdiction and this report is true to the best of my knowledge and belief.<br><b>DOR Well Service 211</b><br>Business name License No. <b>428 W 3rd Newton KS</b><br>Address <b>W. S. Sullivan</b> Date <b>8-24-77</b><br>Signed <b>W. S. Sullivan</b> Authorized representative |              |

23-10-18 SE NW SW  
T R Sec