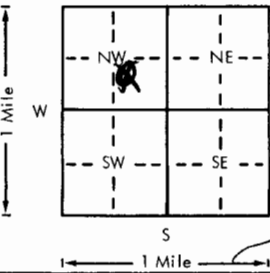
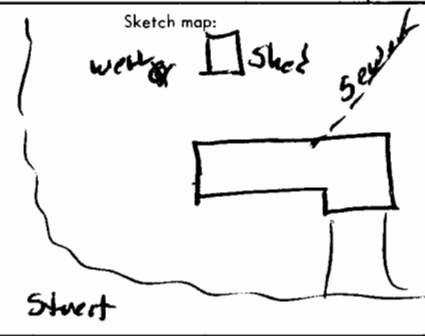


USE TYPEWRITER OR BALL
POINT PEN-PRESS FIRMLY,
PRINT CLEARLY.

WATER WELL RECORD
KSA 82a-1201-1215

Kansas Department of Health and
Environment-Division of Environment
(Water well Contractors)
Topeka, Kansas 66620

1. Location of well:		County HARVEY	Fraction NW 1/4 SE 1/4 NW 1/4	Section number 18	Township number T 23 S R 1	Range number 10E
2. Distance and direction from nearest town or city: Street address of well location if in city:				3. Owner of well: Louis Moler R.R. or street: 817 Spruce ST City, state, zip code: Newton, Kansas		
4. Locate with "X" in section below:		Sketch map:		6. Bore hole dia. 11 in. Completion date 10/13/78 Well depth 48 ft.		
				7. Cable tool <input checked="" type="checkbox"/> Rotary <input type="checkbox"/> Driven <input type="checkbox"/> Dug <input type="checkbox"/> Hollow rod <input type="checkbox"/> Jetted <input type="checkbox"/> Bored <input type="checkbox"/> Reverse rotary		
5. Type and color of material				From	To	8. Use: Domestic <input type="checkbox"/> Public supply <input type="checkbox"/> Industry <input type="checkbox"/> <input checked="" type="checkbox"/> Irrigation <input type="checkbox"/> Air conditioning <input type="checkbox"/> Stock <input checked="" type="checkbox"/> Lawn <input type="checkbox"/> Oil field water <input type="checkbox"/> Other
LOAM to Brown CLAY				0	5	9. Casing: Material PLASTIC Height 12 in. or below Threaded <input type="checkbox"/> Welded <input checked="" type="checkbox"/> Surface 12 in. RMP <input type="checkbox"/> PVC <input checked="" type="checkbox"/> Weight 2.87 lbs./ft. Dia. 5 in. to 48 ft. depth Wall Thickness: inches or Dia. <input type="checkbox"/> in. to <input type="checkbox"/> ft. depth gage No. 1258
RED BROWN CLAY				5	10	10. Screen: Manufacturer's name Kam-Trak Type PLASTIC Dia. 5" Slot/gauze 0.20 Length 10' Set between 39 ft. and 44 ft. 20 ft. and 25 ft. Gravel pack? <input checked="" type="checkbox"/> Size range of material 1/8-1/4
RED/BROWN CLAY to SANDY GREY CLAY				10	15	11. Static water level: 23 ft. below land surface Date 10/13/78
FINE SAND				15	20	12. Pumping level below land surfaces: 48 ft. after 2 hrs. pumping 8 g.p.m. <input type="checkbox"/> ft. after <input type="checkbox"/> hrs. pumping <input type="checkbox"/> g.p.m. Estimated maximum yield 8/10 g.p.m.
GREY SANDY CLAY				20	25	13. Water sample submitted: <input checked="" type="checkbox"/> Yes <input type="checkbox"/> No Date 10/13/78
LIGHT BROWN CLAY				25	40	14. Well head completion: <input type="checkbox"/> Pitless adapter 12 inches above grade
GREY CLAY to GREEN GREY SHALE				40	45	15. Well grouted? <input checked="" type="checkbox"/> With: <input checked="" type="checkbox"/> Neat cement <input type="checkbox"/> Bentonite <input type="checkbox"/> Concrete Depth: From 0 ft. to 10 ft.
GREY SHALE to DARK SHALE				45	48	16. Nearest source of possible contamination: SEWER ft. 45 Direction NB Type LINE Well disinfected upon completion? <input type="checkbox"/> Yes <input checked="" type="checkbox"/> No
(Use a second sheet if needed)						17. Pump: <input type="checkbox"/> Not installed Manufacturer's name Dempster Model number MC-83-2-51 1/3 Volts 215 Length of drop pipe 44 ft. capacity 12 g.p.m. Type: <input checked="" type="checkbox"/> Submersible <input type="checkbox"/> Turbine <input type="checkbox"/> Jet <input type="checkbox"/> Reciprocating <input type="checkbox"/> Centrifugal <input type="checkbox"/> Other
18. Elevation:		19. Remarks:		20. Water well contractor's certification: This well was drilled under my jurisdiction and this report is true to the best of my knowledge and belief. PAUL'S INC #125 Business name License No. Address HESSITON KANSAS Signed Paul Baughman Date 10/13/78 Authorized representative		
Topography: <input type="checkbox"/> Hill <input type="checkbox"/> Slope <input type="checkbox"/> Upland <input type="checkbox"/> Valley		Own groot				

Forward the white, blue and pink copies to the Department of Health and Environment

Form WWC-5