


1 LOCATION OF WATER WELL: Fraction Se 1/4 Sw 1/4 Se 1/4 Section Number 20 Township Number T 23 S Range Number R 1 E  
 County: Harvey

Distance and direction from nearest town or city street address of well if located within city?  
In Newton 1220 Parkwood lane

2 WATER WELL OWNER: Rodger Busenitz  
 RR#, St. Address, Box #: 1220 Parkwood Lane  
 City, State, ZIP Code: Newton, KS 67114-4838  
 Board of Agriculture, Division of Water Resources  
 Application Number:

3 LOCATE WELL'S LOCATION WITH AN "X" IN SECTION BOX:

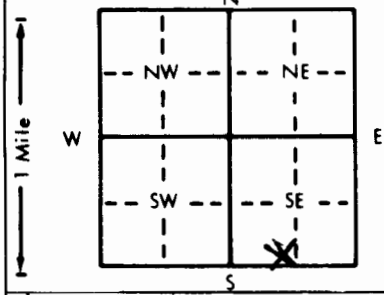

4 DEPTH OF COMPLETED WELL: 74 ft. ELEVATION:  
 Depth(s) Groundwater Encountered: 1. 65 ft. 2. ft. 3. ft.  
 WELL'S STATIC WATER LEVEL: 16 ft. below land surface measured on mo/day/yr  
 Pump test data: Well water was ft. after hours pumping gpm  
 Est. Yield: 20 gpm; Well water was ft. after hours pumping gpm  
 Bore Hole Diameter: 8 1/2 in. to 30 ft., and 7 1/2 in. to 74 ft.  
 WELL WATER TO BE USED AS:  
 5 Public water supply 8 Air conditioning 11 Injection well  
 1 Domestic 3 Feedlot 6 Oil field water supply 9 Dewatering 12 Other (Specify below)  
 2 Irrigation 4 Industrial 7 Lawn and garden only 10 Monitoring well  
 Was a chemical/bacteriological sample submitted to Department? Yes No X; If yes, mo/day/yr sample was submitted  
 Water Well Disinfected? Yes X No

5 TYPE OF BLANK CASING USED:  
 1 Steel 3 RMP (SR) 5 Wrought iron 8 Concrete tile CASING JOINTS: Glued X Clamped  
 2 PVC 4 ABS 6 Asbestos-Cement 9 Other (specify below) Welded  
 7 Fiberglass Threaded  
 Blank casing diameter: 5 in. to 55 ft. Dia. in. to ft. Dia. in. to ft.  
 Casing height above land surface: 12 in., weight class 160 lbs./ft. Wall thickness or gauge No. 214

TYPE OF SCREEN OR PERFORATION MATERIAL:  
 1 Steel 3 Stainless steel 5 Fiberglass 7 PVC 10 Asbestos-cement  
 2 Brass 4 Galvanized steel 6 Concrete tile 8 RMP (SR) 11 Other (specify)  
 9 ABS 12 None used (open hole)

SCREEN OR PERFORATION OPENINGS ARE:  
 1 Continuous slot 3 Mill slot 5 Gauzed wrapped 8 Saw cut 11 None (open hole)  
 2 Louvered shutter 4 Key punched 6 Wire wrapped 9 Drilled holes  
 7 Torch cut 10 Other (specify)

SCREEN-PERFORATED INTERVALS: From 55 ft. to 74 ft., From ft. to ft., From ft. to ft.  
 GRAVEL PACK INTERVALS: From ft. to ft., From ft. to ft., From ft. to ft.

6 GROUT MATERIAL: 1 Neat cement 2 Cement grout 3 Bentonite 4 Other  
 Grout Intervals: From 0 ft. to 20 ft., From ft. to ft., From ft. to ft.  
 What is the nearest source of possible contamination:  
 1 Septic tank 4 Lateral lines 7 Pit privy 10 Livestock pens 14 Abandoned water well  
 2 Sewer lines 5 Cess pool 8 Sewage lagoon 11 Fuel storage 15 Oil well/Gas well  
 3 Watertight sewer lines 6 Seepage pit 9 Feedyard 12 Fertilizer storage 16 Other (specify below)  
 13 Insecticide storage  
 Direction from well? S How many feet? 20

FROM	TO	LITHOLOGIC LOG	FROM	TO	PLUGGING INTERVALS
<u>0</u>	<u>12</u>	<u>Clay</u>			
<u>12</u>	<u>16</u>	<u>Sand</u>			
<u>16</u>	<u>23</u>	<u>Rock White</u>			
<u>23</u>	<u>65</u>	<u>Blue Shale</u>			
<u>65</u>	<u>66</u>	<u>Water</u>			
<u>66</u>	<u>74</u>	<u>Blue Shale</u>			

7 CONTRACTOR'S OR LANDOWNER'S CERTIFICATION: This water well was (1) constructed, (2) reconstructed, or (3) plugged under my jurisdiction and was completed on (mo/day/year) 5-9-94 and this record is true to the best of my knowledge and belief. Kansas Water Well Contractor's License No. 180 This Water Well Record was completed on (mo/day/yr) 5-15-94 under the business name of Backhus Drilling by (signature) Paul H. Backhus