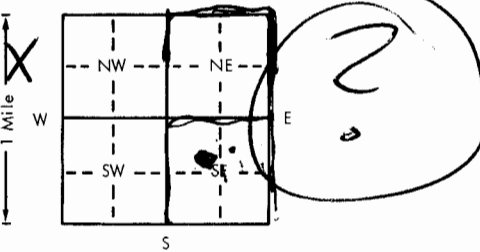


1. Location of well: County <u>Harvey</u>		X Fraction <u>SE 1/4</u>		Section number <u>20</u>		Township number <u>23</u>		Range number <u>1</u>	
2. Distance and direction from nearest town or city: Street address of well location if in city: <u>310 S.E. 10th</u> <u>Newton, Mo.</u>				3. Owner of well: <u>Oscar Miller</u> R.R. or street: <u>310 S-E-10</u> City, state, zip code: <u>Newton Kansas</u>					
4. Locate with "X" in section below: 				Sketch map:		6. Bore hole dia. <u>8</u> in. Completion date <u>11-7-72</u> Well depth <u>99</u> ft.			
5. Type and color of material				From		To		7. <input checked="" type="checkbox"/> Cable tool <input type="checkbox"/> Rotary <input type="checkbox"/> Driven <input type="checkbox"/> Dug	
								<input type="checkbox"/> Hollow rod <input type="checkbox"/> Jetted <input type="checkbox"/> Bored <input type="checkbox"/> Reverse rotary	
cap Soil white clay Brown clay Blue clay Rock Blue Shale Limestone Blue Shale				0		3		8. Use: <input type="checkbox"/> Domestic <input type="checkbox"/> Public supply <input type="checkbox"/> Industry	
								<input checked="" type="checkbox"/> Irrigation <input type="checkbox"/> Air conditioning <input type="checkbox"/> Stock	
				3		6		<input checked="" type="checkbox"/> Lawn <input type="checkbox"/> Oil field water <input type="checkbox"/> Other	
Blue clay				6		14		9. Casing: Material <u>plastic</u> Height: Above or below	
Rock				22		24		Threaded <input type="checkbox"/> Welded <input checked="" type="checkbox"/> Surface <u>18</u> in	
Blue Shale				24		85		RMP <input checked="" type="checkbox"/> PVC <input type="checkbox"/> Weight <u>200</u> lbs./ft	
Limestone				85		88		Dia. <u>5</u> in. to <u> </u> ft. depth Wall Thickness: inches or	
Blue Shale				88		99		Dia. <u> </u> in. to <u> </u> ft. depth Gauge No. <u>2110</u>	
								10. Screen: Manufacturer's name <u>Symphony Plastic, 4" x 1/2"</u>	
								Type <u>RMB</u> Dia. <u>5</u>	
								Slot/gauze <u>3/32</u> Length <u>40</u>	
								Set between <u>20</u> ft. and <u>40</u> ft.	
								Gravel pack? <input checked="" type="checkbox"/> Size range of material <u>1/4 - 1/2</u>	
								11. Static water level: <u>15</u> ft. below land surface Date <u>11-7-72</u>	
								12. Pumping level below land surfaces:	
								<u>15</u> ft. after <u>1</u> hrs. pumping <u>10</u> g.p.m.	
								<u>50</u> ft. after <u> </u> hrs. pumping <u> </u> g.p.m.	
								Estimated maximum yield <u>10</u> g.p.m.	
								13. Water sample submitted: <u> </u> mo./day/yr	
								<u> </u> Yes <input checked="" type="checkbox"/> No <input type="checkbox"/> Date <u>11-7-72</u>	
								14. Well head completion: <u>18</u> inches above grade	
								<u> </u> Pitless adapter	
								15. Well grouted? <input checked="" type="checkbox"/>	
								With: <u> </u> Neat cement <input checked="" type="checkbox"/> Bentonite <input type="checkbox"/> Concrete <input type="checkbox"/>	
								Depth: From <u>top</u> ft. to <u>10</u> ft.	
								16. Nearest source of possible contamination: <u>230</u> ft. Direction <u>N-W</u> Type <u>cock</u>	
								Well disinfected upon completion? <input checked="" type="checkbox"/> Yes <input type="checkbox"/> No <input type="checkbox"/>	
								17. Pump: <u> </u> Non installed	
								Manufacturer's name <u>Gould</u>	
								Model number <u> </u> HP <u>3</u> Volts <u>115</u>	
								Length of drop pipe <u>90</u> ft. capacity <u>8</u> g.p.m.	
								Type:	
								<input checked="" type="checkbox"/> Submersible <input type="checkbox"/> Turbine	
								<input type="checkbox"/> Jet <input type="checkbox"/> Reciprocating	
								<input type="checkbox"/> Centrifugal <input type="checkbox"/> Other	
18. Elevation:		19. Remarks:		20. Water well contractor's certification: This well was drilled under my jurisdiction and this report is true to the best of my knowledge and belief. <u>Jerome Buddle 221</u> Business name <u>R4 Newton Kansas</u> License No. <u> </u> Address <u> </u> Signed <u>Jerome Buddle</u> Date <u>12-3</u> Authorized representative					