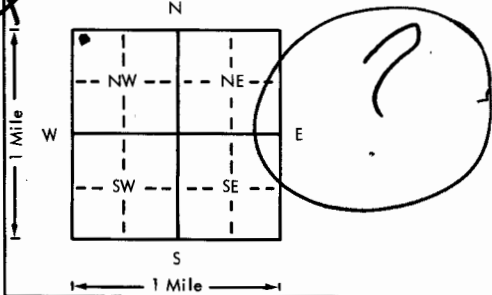


USE TYPEWRITER OR BALL
POINT PEN-PRESS FIRMLY,
PRINT CLEARLY.

WATER WELL RECORD
KSA 82a-1201-1215

Kansas Department of Health and
Environment-Division of Environment
(Water well Contractors)
Topeka, Kansas 66620

1. Location of well:		County <u>Harvey</u>	Fraction <u>NW 1/4 NW 1/4 NW 1/4</u>	Section number <u>21</u>	Township number <u>23</u>	Range number <u>1</u>	EW
2. Distance and direction from nearest town or city:		3. Owner of well:		120 S Kansas Ave NEWTON KS.			
Street address of well location if in city:		R.R. or street:		City, state, zip code: <u>Newton Kansas</u>			
4. Locate with "X" in section below:		Sketch map:		6. Bore hole dia. <u>8</u> in. Completion date <u>10-30-78</u> Well depth <u>77</u> ft.			
				7. <input checked="" type="checkbox"/> Cable tool <input type="checkbox"/> Rotary <input type="checkbox"/> Driven <input type="checkbox"/> Dug <input type="checkbox"/> Hollow rod <input type="checkbox"/> Jetted <input type="checkbox"/> Bored <input type="checkbox"/> Reverse rotary			
5. Type and color of material		From		To		8. Use: <input type="checkbox"/> Domestic <input type="checkbox"/> Public supply <input type="checkbox"/> Industry <input type="checkbox"/> Irrigation <input type="checkbox"/> Air conditioning <input type="checkbox"/> Stock <input checked="" type="checkbox"/> Lawn <input type="checkbox"/> Oil field water <input type="checkbox"/> Other	
<u>cap soil</u>		<u>0</u>		<u>4</u>		9. Casing: Material <u>plastic</u> Height: Above or below Threaded <input type="checkbox"/> Welded <input checked="" type="checkbox"/> Surface <u>18</u> in. RMP <input checked="" type="checkbox"/> PVC <input type="checkbox"/> Weight <u>200</u> lbs./ft. Dia. <u>5</u> in. to <u>77</u> ft. depth Wall Thickness: inches or Dia. <u>5</u> in. to <u>77</u> ft. depth gage No. <u>2110</u>	
<u>Blue clay</u>		<u>4</u>		<u>20</u>		10. Screen: Manufacturer's name <u>Sunflow plastic pipe line</u> Type <u>RMP</u> Dia. <u>5</u> Slot/gauze <u>3/32</u> Length <u>35</u> Set between <u>30</u> ft. and <u>65</u> ft. Gravel pack? <input checked="" type="checkbox"/> Size range of material <u>8-24</u>	
<u>Rock</u>		<u>20</u>		<u>23</u>		11. Static water level: <u>22</u> ft. below land surface Date <u>10-30-78</u>	
<u>Blue shale</u>		<u>23</u>		<u>65</u>		12. Pumping level below land surfaces: <u>22</u> ft. after <u>1</u> hrs. pumping <u>10</u> g.p.m. <u>40</u> ft. after <u> </u> hrs. pumping <u> </u> g.p.m. Estimated maximum yield <u>10</u> g.p.m.	
<u>Limestone</u>		<u>65</u>		<u>67</u>		13. Water sample submitted: <u> </u> mo./day/yr. <input type="checkbox"/> Yes <input checked="" type="checkbox"/> No Date <u> </u>	
<u>Blue shale</u>		<u>67</u>		<u>77</u>		14. Well head completion: <input type="checkbox"/> Pitless adapter <u>18</u> inches above grade	
						15. Well grouted? <input checked="" type="checkbox"/> With: <input type="checkbox"/> Neat cement <input checked="" type="checkbox"/> Bentonite <input type="checkbox"/> Concrete Depth: From <u>top</u> ft. to <u>10</u> ft.	
						16. Nearest source of possible contamination: ft. <u>200</u> Direction <u>N</u> Type <u>gas pump</u> Well disinfected upon completion? <input checked="" type="checkbox"/> Yes <input type="checkbox"/> No	
						17. Pump: <input checked="" type="checkbox"/> Not installed Manufacturer's name <u> </u> Model number <u> </u> HP <u> </u> Volts <u> </u> Length of drop pipe <u> </u> ft. capacity <u> </u> g.p.m. Type: <input type="checkbox"/> Submersible <input type="checkbox"/> Turbine <input type="checkbox"/> Jet <input type="checkbox"/> Reciprocating <input type="checkbox"/> Centrifugal <input type="checkbox"/> Other	
18. Elevation:		19. Remarks:		20. Water well contractor's certification: This well was drilled under my jurisdiction and this report is true to the best of my knowledge and belief. <u>Donah Buddle</u> <u>221</u> Business name <u>R 4 Newton Kansas</u> License No. <u> </u> Address <u> </u> Signed <u>Donah Buddle</u> Date <u>12-2</u> Authorized representative			