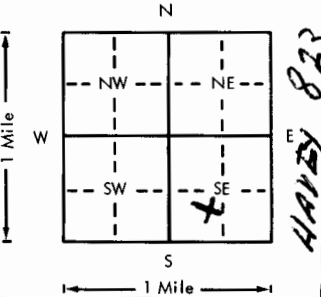
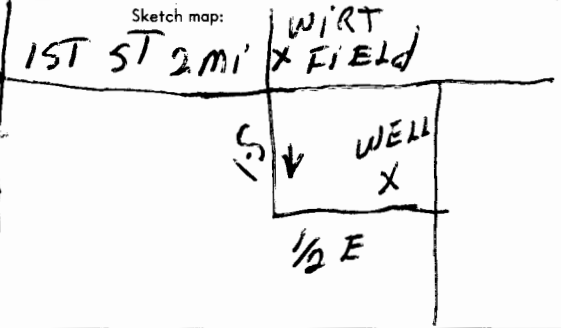


USE TYPEWRITER OR BALL
POINT PEN-PRESS FIRMLY,
PRINT CLEARLY.

WATER WELL RECORD
KSA 82a-1201-1215

Kansas Department of Health and
Environment-Division of Environment
(Water well Contractors)
Topeka, Kansas 66620

1. Location of well:		County HARVEY	Fraction NE 1/4 SW 1/4 SE 1/4	Section number 24	Township number T 23	Range number S R 1	E
2. Distance and direction from nearest town or city: OF ROAD 823 ON 1ST STREET		3. Owner of well: MIKE ENTZ		R.R. or street: RED 3			
Street address of well location if in city:		City, state, zip code: NEWTON KS 67114					
4. Locate with "X" in section below:		Sketch map: WIRT 1ST ST 2 mi' X FIELD		6. Bore hole dia. 10 in. Completion date 10-15 Well depth 55 ft. 1779			
				7. ☒ Cable tool ☒ Rotary ☐ Driven ☐ Dug ☐ Hollow rod ☐ Jetted ☐ Bored ☐ Reverse rotary			
5. Type and color of material		From		To		8. Use: ☐ Domestic ☐ Public supply ☐ Industry ☐ Irrigation ☐ Air conditioning ☒ Stock ☐ Lawn ☐ Oil field water ☐ Other	
TOP SOIL		0		2		9. Casing: Material PVC Height: Above or below Threaded ☐ Welded ☐ Surface 18 in. RMP ☒ PVC ☐ Weight 1.50 lbs./ft. Dia. 5 in. to 55 ft. depth Wall Thickness: inches or Dia. ☐ in. to ☐ ft. depth gage No. 200	
CLAY YELLOW		2		8		10. Screen: Manufacturer's name SURMAC	
SANDY CLAY		8		20		Type RMP Dia. 5 Slot/gauze .06 Length 20 Set between 25 ft. and 45 ft. Gravel pack? yes Size range of material 48-14	
SAND FINE		20		40		11. Static water level: 10 ft. below land surface Date 10-15-79	
SHALE BLACK		40		55		12. Pumping level below land surfaces: 35 ft. after 1 hrs. pumping 7 g.p.m. ft. after ☐ hrs. pumping ☐ g.p.m. Estimated maximum yield 7 g.p.m.	
						13. Water sample submitted: Yes ☒ No ☐ Date	
						14. Well head completion: No Pitless adapter ☐ Inches above grade	
						15. Well grouted? yes With: ☒ Neat cement ☐ Bentonite ☐ Concrete Depth: From 0 ft. to 10 ft.	
						16. Nearest source of possible contamination: ft. 200 Direction NE Type LAGOON Well disinfected upon completion? ☒ Yes ☐ No	
						17. Pump: Manufacturer's name RPT JACKET Not installed Model number 50198C HP 1 1/2 Volts 230 Length of drop pipe 45 ft. capacity 10 g.p.m. Type: ☒ Submersible ☐ Turbine ☐ Jet ☐ Reciprocating ☐ Centrifugal ☐ Other	
18. Elevation:		19. Remarks:		20. Water well contractor's certification: This well was drilled under my jurisdiction and this report is true to the best of my knowledge and belief. DARWELL SERVICE Business name 4068 Highway Rd Newton KS License No. Address W. Phillips Signed 12-179 Authorized representative			