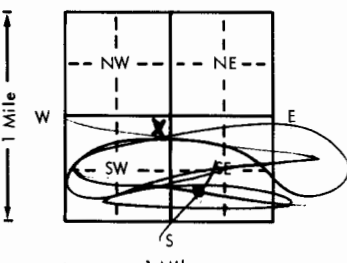


USE TYPEWRITER OR BALL
POINT PEN-PRESS FIRMLY,
PRINT CLEARLY.

WATER WELL RECORD
KSA 82a-1201-1215

Kansas Department of Health and
Environment-Division of Environment
(Water well Contractors)
Topeka, Kansas 66620

1. Location of well: County <u>Harvey</u> Fraction <u>NE 1/4 NE 1/4 SW 1/4</u> Section number <u>27</u> Township number <u>T 23</u> Range number <u>R 1 E</u> <u>EW</u>	
2. Distance and direction from nearest town or city: <u>NEWTON, KS.</u> Street address of well location if in city: <u>505 S W 11th</u>	
3. Owner of well: <u>Jerome Budd</u> R.R. or street: <u>Newton Kansas</u> City, state, zip code: <u>Newton Kansas</u>	
4. Locate with "X" in section below: Sketch map: 	
5. Type and color of material	
6. Bore hole dia. <u>10-8</u> in. Completion date <u>May 10 1978</u> Well depth <u>49</u> ft.	
7. <input checked="" type="checkbox"/> Cable tool <input type="checkbox"/> Rotary <input type="checkbox"/> Driven <input type="checkbox"/> Dug <input type="checkbox"/> Hollow rod <input type="checkbox"/> Jetted <input type="checkbox"/> Bored <input type="checkbox"/> Reverse rotary	
8. Use: <input checked="" type="checkbox"/> Domestic <input type="checkbox"/> Public supply <input type="checkbox"/> Industry <input type="checkbox"/> Irrigation <input type="checkbox"/> Air conditioning <input type="checkbox"/> Stock <input type="checkbox"/> Lawn <input type="checkbox"/> Oil field water <input type="checkbox"/> Other	
9. Casing: Material <u>plastic</u> Height: Above or below Threaded <input type="checkbox"/> Welded <input checked="" type="checkbox"/> Surface <u>14</u> in. RMP <input checked="" type="checkbox"/> PVC <input type="checkbox"/> Weight <u>200</u> lbs./ft. Dia. <u>5</u> in. to <u>49</u> ft. depth Wall Thickness: inches or Dia. <u>5</u> in. to <u>49</u> ft. depth gage No. <u>270</u>	
10. Screen: Manufacturer's name <u>Sumplow Plastic pipe corp</u> Type <u>RMP</u> Dia. <u>5</u> Slot/gauze <u>3/32</u> Length <u>20</u> Set between <u>30</u> ft. and <u>40</u> ft. Gravel pack? <input checked="" type="checkbox"/> Size range of material <u>1/4 - 1/2</u>	
11. Static water level: <u>15</u> ft. below land surface Date <u>May 11 1978</u>	
12. Pumping level below land surfaces: <u>15</u> ft. after <u>1</u> hrs. pumping <u>6</u> g.p.m. <u>40</u> ft. after <u> </u> hrs. pumping <u> </u> g.p.m. Estimated maximum yield <u>6</u> g.p.m.	
13. Water sample submitted: <u> </u> mo./day/yr. <input checked="" type="checkbox"/> Yes <input type="checkbox"/> No Date <u>May 12 - 1978</u>	
14. Well head completion: <input checked="" type="checkbox"/> Pitless adapter <u>18</u> inches above grade	
15. Well grouted? <input checked="" type="checkbox"/> With: <input checked="" type="checkbox"/> Neat cement <input checked="" type="checkbox"/> Bentonite <input type="checkbox"/> Concrete Depth: From <u>3</u> ft. to <u>49</u> ft.	
16. Nearest source of possible contamination: ft. <u>60</u> Direction <u>S</u> Type <u>Spring tank</u> Well disinfected upon completion? <input checked="" type="checkbox"/> Yes <input type="checkbox"/> No	
17. Pump: <u>Not installed</u> Manufacturer's name <u>gottlieb</u> Model number <u> </u> HP <u>1/2</u> Volts <u>115</u> Length of drop pipe <u>43</u> ft. capacity <u>6</u> g.p.m. Type: <input checked="" type="checkbox"/> Submersible <input type="checkbox"/> Turbine <input type="checkbox"/> Jet <input type="checkbox"/> Reciprocating <input type="checkbox"/> Centrifugal <input type="checkbox"/> Other	
(Use a second sheet if needed)	
18. Elevation: Topography: <input type="checkbox"/> Hill <input type="checkbox"/> Slope <input type="checkbox"/> Upland <input checked="" type="checkbox"/> Valley	19. Remarks: <u>NAME: DWIGHT NICKEL</u> <u>RR #3</u> <u>NEWTON, KS</u>
20. Water well contractor's certification: This well was drilled under my jurisdiction and this report is true to the best of my knowledge and belief. <u>Jerome Budd</u> <u>221</u> Business name <u>Q4 Newton Kansas</u> License No. Address <u> </u> Signed <u>Jerome Budd</u> Date <u>June 1978</u> Authorized representative	