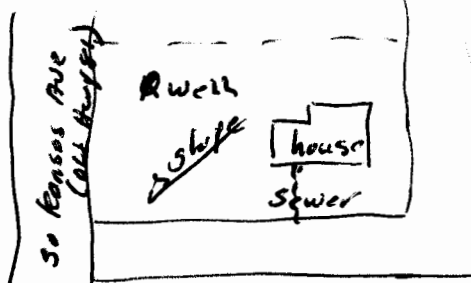


USE TYPEWRITER OR BALL
POINT PEN-PRESS FIRMLY,
PRINT CLEARLY.

WATER WELL RECORD
KSA 82a-1201-1215

Kansas Department of Health and
Environment-Division of Environment
(Water well Contractors)
Topeka, Kansas 66620

1. Location of well:	County HARVEY	Fraction SW 1/4 NW 1/4 SW 1/4	Section number 28	Township number T 23 S	Range number R 1 E
2. Distance and direction from nearest town or city: Street address of well location if in city:	1/2 mile So of Newton		3. Owner of well: R.R. or street: City, state, zip code:		
4. Locate with "X" in section below: N W E S 1 Mile Sketch map: 			6. Bore hole dia. 14 in. Completion date Well depth 63 ft. 9/12/78		
5. Type and color of material			From	To	7. <input checked="" type="checkbox"/> Cable tool <input checked="" type="checkbox"/> Rotary <input type="checkbox"/> Driven <input type="checkbox"/> Dug <input type="checkbox"/> Hollow rod <input type="checkbox"/> Jetted <input type="checkbox"/> Bored <input type="checkbox"/> Reverse rotary
LEAM to CLAY			0	5	8. Use: <input type="checkbox"/> Domestic <input type="checkbox"/> Public supply <input type="checkbox"/> Industry <input checked="" type="checkbox"/> Irrigation <input type="checkbox"/> Air conditioning <input type="checkbox"/> Stock <input checked="" type="checkbox"/> Lawn <input type="checkbox"/> Oil field water <input type="checkbox"/> Other
Red/Brown CLAY to soft shale			5	10	9. Casing: Material plastic Height: Above or below Threaded <input type="checkbox"/> Welded <input type="checkbox"/> Surface 18 in. RMP <input type="checkbox"/> PVC <input checked="" type="checkbox"/> Weight 342 lbs./ft.
Light GREY soft shale			10	15	Dia. 6 in. to 63 ft. depth Wall Thickness: inches or Dia. <input type="checkbox"/> in. to <input type="checkbox"/> ft. depth gage No. .280
Red soft SHALE			15	17	10. Screenshot: Manufacturer's name Kem-Tech
GREY SHALE			17	20	Type PVC Dia. 6"
DARK GREY SHALE - LAYERED			20	55	Slot/gauze .020 Length 10'
GREY SHALE - faulted			55	67	Set between <input type="checkbox"/> ft. and <input type="checkbox"/> ft. <input type="checkbox"/> ft. and <input type="checkbox"/> ft.
White LIME Rock			67	69	Gravel pack? <input checked="" type="checkbox"/> Size range of material 1/8-1/4
DARK GREY SHALE			69	78	11. Static water level: <input type="checkbox"/> mo./day/yr. 12 ft. below land surface Date <input type="checkbox"/>
					12. Pumping level below land surfaces: <input type="checkbox"/> ft. after <input type="checkbox"/> hrs. pumping <input type="checkbox"/> g.p.m. 41 ft. after 3 hrs. pumping 15 g.p.m. Estimated maximum yield 15 g.p.m.
					13. Water sample submitted: <input type="checkbox"/> mo./day/yr. <input type="checkbox"/> Yes <input checked="" type="checkbox"/> No Date <input type="checkbox"/>
					14. Well head completion: <input type="checkbox"/> Pitless adapter 18 Inches above grade
					15. Well grouted? <input checked="" type="checkbox"/> With: <input checked="" type="checkbox"/> Neat cement <input type="checkbox"/> Bentonite <input type="checkbox"/> Concrete Depth: From 10 ft. to 0 ft.
					16. Nearest source of possible contamination: house ft. 80 Direction So. Type sewer Well disinfected upon completion? <input type="checkbox"/> Yes <input checked="" type="checkbox"/> No
					17. Pump: <input checked="" type="checkbox"/> Not installed Manufacturer's name <input type="checkbox"/> Model number <input type="checkbox"/> HP <input type="checkbox"/> Volts <input type="checkbox"/> Length of drop pipe <input type="checkbox"/> ft. capacity <input type="checkbox"/> g.p.m. Type: <input type="checkbox"/> Submersible <input type="checkbox"/> Turbine <input type="checkbox"/> Jet <input type="checkbox"/> Reciprocating <input type="checkbox"/> Centrifugal <input type="checkbox"/> Other
(Use a second sheet if needed)					
18. Elevation: Topography: <input type="checkbox"/> Hill <input type="checkbox"/> Slope <input type="checkbox"/> Upland <input type="checkbox"/> Valley	19. Remarks:		20. Water well contractor's certification: This well was drilled under my jurisdiction and this report is true to the best of my knowledge and belief. PAUL'S INC. #175 Business name Hesston, KS License No. Address Paul Paulson Signed Paul Paulson Date 10/10/78 Authorized representative		

Forward the white, blue and pink copies to the Department of Health and Environment

Form WWC-5