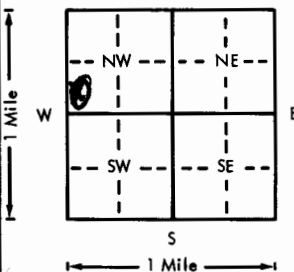
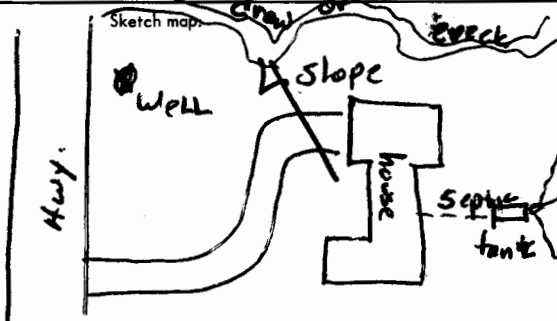


USE TYPEWRITER OR BALL
POINT PEN-PRESS FIRMLY,
PRINT CLEARLY.

WATER WELL RECORD
KSA 82a-1201-1215

Kansas Department of Health and
Environment-Division of Environment
(Water well Contractors)
Topeka, Kansas 66620

1. Location of well:		County HARVEY	Fraction NW 1/4 SW 1/4 NW 1/4	Section number 33	Township number T 23 S R 1 E/W	Range number 1
2. Distance and direction from nearest town or city: Street address of well location if in city:		1 1/2 mile So. of Newton		3. Owner of well: R.R. or street: City, state, zip code:		
4. Locate with "X" in section below:		Sketch map:		6. Bore hole dia. 14 in. Completion date 11-14-77 Well depth 11-14-77		
				7. <input checked="" type="checkbox"/> Cable tool <input checked="" type="checkbox"/> Rotary <input type="checkbox"/> Driven <input type="checkbox"/> Dug <input type="checkbox"/> Hollow rod <input type="checkbox"/> Jetted <input type="checkbox"/> Bored <input type="checkbox"/> Reverse rotary		
5. Type and color of material		From		To		8. Use: <input checked="" type="checkbox"/> Domestic <input type="checkbox"/> Public supply <input type="checkbox"/> Industry <input type="checkbox"/> Irrigation <input type="checkbox"/> Air conditioning <input type="checkbox"/> Stock <input type="checkbox"/> Lawn <input type="checkbox"/> Oil field water <input type="checkbox"/> Other
SANDY LOAM		0		5		9. Casing: Material plastic Height Above or below Threaded <input type="checkbox"/> Welded <input type="checkbox"/> Surface 48 in. RMP <input type="checkbox"/> PVC <input checked="" type="checkbox"/> Weight 23 lbs./ft. Dia. 6 in. to 92 ft. depth Wall Thickness: inches or Dia. 6 in. to 92 ft. depth gage No. 280
DARK BROWN CLAY		5		17		10. Screen: Manufacturer's name Western - own slot Type 2046 Dia. 28 Slot/gauze 15 Length 23 Set between 15 ft. and 23 ft. 26 ft. and 36 ft. 88'
LAYERED GREY-GREEN SHALE		17		21		Gravel pack? <input checked="" type="checkbox"/> Size range of material 1/8-1/4
DARK GREY SHALE		21		30		11. Static water level: 4' ft. below land surface Date 11-14-77
" " " (faulted)		30		33		12. Pumping level below land surfaces: 40 ft. after 1 1/2 hrs. pumping 8 g.p.m. 40 ft. after 1 1/2 hrs. pumping 8 g.p.m. Estimated maximum yield 8 g.p.m.
" " "		33		52		13. Water sample submitted: 8 mo./day/yr. <input type="checkbox"/> Yes <input checked="" type="checkbox"/> No Date
WHITE HARD ROCK		52		54		14. Well head completion: <input checked="" type="checkbox"/> Pitless adapter 1 inches above grade
DARK GREY SHALE		54		64		15. Well grouted? <input checked="" type="checkbox"/> With: <input checked="" type="checkbox"/> Neat cement <input type="checkbox"/> Bentonite <input type="checkbox"/> Concrete Depth: From 15 ft. to 0 ft.
WHITE HARD ROCK		64		65		16. Nearest source of possible contamination: ft. 30 Direction North Type creek Well disinfected upon completion? <input checked="" type="checkbox"/> Yes <input type="checkbox"/> No
DARK GREY SHALE		65		83		17. Pump: <input checked="" type="checkbox"/> Not installed Manufacturer's name Model number HP Volts Length of drop pipe ft. capacity g.p.m. Type: <input type="checkbox"/> Submersible <input type="checkbox"/> Turbine <input type="checkbox"/> Jet <input type="checkbox"/> Reciprocating <input type="checkbox"/> Centrifugal <input type="checkbox"/> Other
" " " (faulted)		83		85		20. Water well contractor's certification: This well was drilled under my jurisdiction and this report is true to the best of my knowledge and belief. PAUL'S INC #175 Business name License No. Address Box 26 Hesston, KS Signed Paul B. Buehler Date 11-14-77 Authorized representative
" " "		85		92		
18. Elevation:		19. Remarks:				
Topography: <input checked="" type="checkbox"/> Hill <input checked="" type="checkbox"/> Slope <input type="checkbox"/> Upland <input type="checkbox"/> Valley						

Forward the white, blue and pink copies to the Department of Health and Environment

Form WWC-5