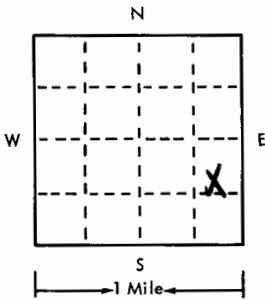


USE TYPEWRITER OR BALL
POINT PEN-PRESS FIRMLY,
PRINT CLEARLY.

WATER WELL RECORD
KSA 82a-1201-1215

T R EW sec 1/4 1/4 1/4 No.

Kansas State Dept. Of Health
(Water Well Contractors)
Forbes-Bldg. 740
Topeka, Kansas 66620

1 Location of well:	County HARVEY	Township name NEWTON	Fraction NE 1/4 - SE 1/4	Section number 36	Town number T-23-5	Range number R-1-E			
Distance and direction from nearest town or city: 1/2 North of McLains			3 Owner of well: DALE GRIFFEN						
Street address of well location if in city:			Address: 309 - W 3rd - NEWTON						
Locate with "X" in section below: 		Sketch map: DAC		4 Well depth: 60 ft. Date of completion 5/23/75 Well diameter 6" in. 12" bore					
2		Type and color of material		From		To		5 <input type="checkbox"/> Cable tool <input checked="" type="checkbox"/> Rotary <input type="checkbox"/> Driven <input type="checkbox"/> Dug <input type="checkbox"/> Hollow rod <input type="checkbox"/> Jetted <input type="checkbox"/> Bored <input type="checkbox"/> Reverse rotary	
								6 Use: <input checked="" type="checkbox"/> Domestic <input type="checkbox"/> Public supply <input type="checkbox"/> Industry <input type="checkbox"/> Irrigation <input type="checkbox"/> Air conditioning <input type="checkbox"/> Commercial <input type="checkbox"/> Test well <input type="checkbox"/>	
								7 Casing: Material PVC Height: above/below Threaded <input type="checkbox"/> Welded <input checked="" type="checkbox"/> Surface 12 in. Diam. 6" Weight 3.22 lbs./ft. 0 in. to 60 ft. depth Drive shoe? <input type="checkbox"/> Yes <input checked="" type="checkbox"/> No in. to ft. depth	
								8 Screen: OWN SLOT Manufacturer CERT-TEED Type PVC Dia. 6" Slot/gauze 10/46 Length 20' Set between 15 ft. and 33 ft. Fittings: 1/8" - 3/8" Gravel pack <input checked="" type="checkbox"/> Yes <input type="checkbox"/> No Size range of material	
								9 Static water level: ft. below land surface Date 5/23/75	
								10 Pumping level below land surfaces: 32' ft. after 1 hrs. pumping 10 g.p.m. ft. after hrs. pumping g.p.m. Estimated maximum yield 10 g.p.m.	
								11 Water sample submitted: <input type="checkbox"/> Yes <input checked="" type="checkbox"/> No Date	
								12 Well head completion: <input type="checkbox"/> Pitless adapter <input checked="" type="checkbox"/> 12" inches above grade	
								13 Well grouted? <input checked="" type="checkbox"/> Yes <input type="checkbox"/> No <input checked="" type="checkbox"/> Neat cement <input type="checkbox"/> Bentonite <input type="checkbox"/> Depth: From ft. to ft.	
								14 Nearest source of possible contamination: ft. 45 Direction South Type house sewer line Well disinfected upon completion? <input checked="" type="checkbox"/> Yes <input type="checkbox"/> No	
								15 Pump: <input checked="" type="checkbox"/> Not installed Manufacturer's name Model number HP Volts Length of drop pipe ft. capacity g.m.p. Type: <input type="checkbox"/> Submersible <input type="checkbox"/> Turbine <input type="checkbox"/> Jet <input type="checkbox"/> Reciprocating <input type="checkbox"/> Centrifugal <input type="checkbox"/> Other	
								16 Remarks: elevation	
								17 Water well contractor's certification: This well was drilled under my jurisdiction and this report is true to the best of my knowledge and belief. PAULUS INC #175 Business name License No. Address Box 26 - Heaton Signed Paul Paulus Date 5/23/75 Authorized representative	
								Topography: <input type="checkbox"/> Hill <input type="checkbox"/> Slope <input checked="" type="checkbox"/> Upland <input type="checkbox"/> Valley	
								(use a second sheet if needed)	