


1] LOCATION OF WATER WELL: County: *Harvey* Fraction: *NW 1/4 NW 1/4 SE 1/4* Section Number: *8* Township Number: *T 23 S* Range Number: *R 1* EW

Distance and direction from nearest town or city street address of well if located within city?
1808 North Main, Newton *MW-8*

2] WATER WELL OWNER: *Summerfeld Penner*
 RR#, St. Address, Box #: *616 North Plum* Board of Agriculture, Division of Water Resources
 City, State, ZIP Code: *Newton, Kansas* Application Number:

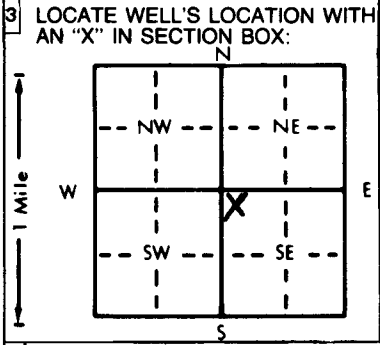

4] DEPTH OF COMPLETED WELL: *15* ft. ELEVATION: *1426.21*
 Depth(s) Groundwater Encountered 1. *7* ft. 2. ft. 3. ft.
 WELL'S STATIC WATER LEVEL: *7.08* ft. below land surface measured on *mo/day/yr* *11/10/98*
 Pump test data: Well water was ft. after hours pumping gpm
 Est. Yield gpm: Well water was ft. after hours pumping gpm
 Bore Hole Diameter: *8* in. to *15* ft., and in. to ft.
 WELL WATER TO BE USED AS:
 5 Public water supply 8 Air conditioning 11 Injection well
 1 Domestic 3 Feedlot 6 Oil field water supply 9 Dewatering 12 Other (Specify below)
 2 Irrigation 4 Industrial 7 Lawn and garden only Monitoring well
 Was a chemical/bacteriological sample submitted to Department? Yes No ; If yes, mo/day/yr sample was submitted
 Water Well Disinfected? Yes No

5] TYPE OF BLANK CASING USED:
 1 Steel 3 RMP (SR) 5 Wrought iron 8 Concrete tile CASING JOINTS: Glued Clamped
 PVC 4 ABS 7 Fiberglass 9 Other (specify below) Welded
 Blank casing diameter: *2* in. to *5* ft., Dia. in. to ft., Dia. in. to ft.
 Casing height above land surface: *Flush mount* in., weight lbs./ft. Wall thickness or gauge No.
 TYPE OF SCREEN OR PERFORATION MATERIAL:
 1 Steel 3 Stainless steel 5 Fiberglass 8 RMP (SR) 10 Asbestos-cement
 2 Brass 4 Galvanized steel 6 Concrete tile 9 ABS 11 Other (specify)
 12 None used (open hole)
 SCREEN OR PERFORATION OPENINGS ARE:
 1 Continuous slot Mill slot 5 Gauzed wrapped 8 Saw cut 11 None (open hole)
 2 Louvered shutter 4 Key punched 6 Wire wrapped 9 Drilled holes
 7 Torch cut 10 Other (specify)
 SCREEN-PERFORATED INTERVALS: From *5* ft. to *15* ft., From ft. to ft.
 From ft. to ft., From ft. to ft.
 GRAVEL PACK INTERVALS: From *4* ft. to *15* ft., From ft. to ft.
 From ft. to ft., From ft. to ft.

6] GROUT MATERIAL: 1 Neat cement 2 Cement grout 3 Bentonite 4 Other: *Concrete*
 Grout Intervals: From *4* ft. to *1* ft., From *1* ft. to *8* ft., From ft. to ft.
 What is the nearest source of possible contamination:
 1 Septic tank 4 Lateral lines 7 Pit privy Fuel storage 10 Livestock pens 14 Abandoned water well
 2 Sewer lines 5 Cess pool 8 Sewage lagoon 12 Fertilizer storage 15 Oil well/Gas well
 3 Watertight sewer lines 6 Seepage pit 9 Feedyard 13 Insecticide storage 16 Other (specify below)

Direction from well? *East* How many feet? *150*

FROM	TO	LITHOLOGIC LOG	FROM	TO	PLUGGING INTERVALS
0	4"	concrete			
4"	3.0'	clay, reddish brown			
3.0'	4.5'	sand, brown			
4.5'	5.6'	clay yellowish brown			
5.6'	9.8'	clay brown			
9.8'	15'	clay w/sand, greenish gray			

7] CONTRACTOR'S OR LANDOWNER'S CERTIFICATION: This water well was constructed, (2) reconstructed, or (3) plugged under my jurisdiction and was completed on (mo/day/year) *10/6/98* and this record is true to the best of my knowledge and belief. Kansas Water Well Contractor's License No. *565* This Water Well Record was completed on (mo/day/yr) *11/10/98* under the business name of *Acer Max Drilling LLC* by (signature) *David Penner*

OFFICE USE ONLY
T
R
EW
SEC.
1/4
1/4
1/4