


1 LOCATION OF WATER WELL: County: Harvey Fraction: NW 1/4 NW 1/4 SE 1/4 Section Number: 8 Township Number: T 23 S Range Number: R 1 E/W

Distance and direction from nearest town or city street address of well if located within city?
1808 North Main, Newton MW-7

2 WATER WELL OWNER: Summerfeld Penner Board of Agriculture, Division of Water Resources
 RR#, St. Address, Box #: 606 North Plum Application Number:
 City, State, ZIP Code: Newton, Kansas

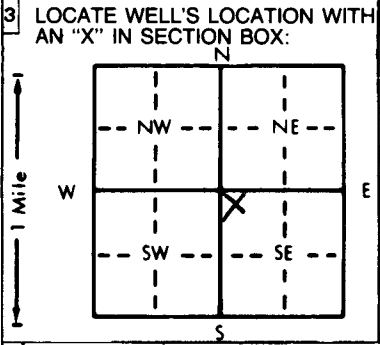

4 DEPTH OF COMPLETED WELL: 15 ft. ELEVATION: 1424.43
 Depth(s) Groundwater Encountered 1. 7 ft. 2. _____ ft. 3. _____ ft.
 WELL'S STATIC WATER LEVEL: 5.52 ft. below land surface measured on mo/day/yr 11/10/98
 Pump test data: Well water was _____ ft. after _____ hours pumping _____ gpm
 Est. Yield _____ gpm: Well water was _____ ft. after _____ hours pumping _____ gpm
 Bore Hole Diameter: 8 in. to 15 ft., and _____ in. to _____ ft.
 WELL WATER TO BE USED AS:
 5 Public water supply 8 Air conditioning 11 Injection well
 1 Domestic 3 Feedlot 6 Oil field water supply 9 Dewatering 12 Other (Specify below)
 2 Irrigation 4 Industrial 7 Lawn and garden only 10 Monitoring well
 Was a chemical/bacteriological sample submitted to Department? Yes No; If yes, mo/day/yr sample was submitted _____
 Water Well Disinfected? Yes No

5 TYPE OF BLANK CASING USED:
 1 Steel 3 RMP (SR) 5 Wrought iron 8 Concrete tile CASING JOINTS: Glued _____ Clamped _____
2 PVC 4 ABS 7 Fiberglass _____ Threaded _____
 6 Asbestos-Cement 9 Other (specify below) Welded _____
 Blank casing diameter: 2 in. to 5 ft., Dia _____ in. to _____ ft., Dia _____ in. to _____ ft.
 Casing height above land surface: Flush mount in., weight _____ lbs./ft. Wall thickness or gauge No. _____
 TYPE OF SCREEN OR PERFORATION MATERIAL:
 1 Steel 3 Stainless steel 5 Fiberglass 8 RMP (SR) 10 Asbestos-cement 11 Other (specify) _____
 2 Brass 4 Galvanized steel 6 Concrete tile 9 ABS 12 None used (open hole)
 SCREEN OR PERFORATION OPENINGS ARE:
 1 Continuous slot 3 Mill slot 5 Gauzed wrapped 8 Saw cut 11 None (open hole)
 2 Louvered shutter 4 Key punched 6 Wire wrapped 9 Drilled holes
 7 Torch cut 10 Other (specify) _____
 SCREEN-PERFORATED INTERVALS: From 5 ft. to 15 ft., From _____ ft. to _____ ft.
 From _____ ft. to _____ ft., From _____ ft. to _____ ft.
 GRAVEL PACK INTERVALS: From 4 ft. to 15 ft., From _____ ft. to _____ ft.
 From _____ ft. to _____ ft., From _____ ft. to _____ ft.

6 GROUT MATERIAL: 1 Neat cement 2 Cement grout 3 Bentonite 4 Other concrete
 Grout Intervals: From 4 ft. to 1 ft., From 1 ft. to 8 ft., From _____ ft. to _____ ft.
 What is the nearest source of possible contamination:
 1 Septic tank 4 Lateral lines 7 Pit privy 11 Fuel storage 14 Abandoned water well
 2 Sewer lines 5 Cess pool 8 Sewage lagoon 12 Fertilizer storage 15 Oil well/Gas well
 3 Watertight sewer lines 6 Seepage pit 9 Feedyard 13 Insecticide storage 16 Other (specify below)
 Direction from well? North How many feet? 75

FROM	TO	LITHOLOGIC LOG	FROM	TO	PLUGGING INTERVALS
0	5.2'	clay, black			
5.2	8.5	clay, reddish brown			
8.5	15.0	clay, w/ sand, greenish gray wet			

7 CONTRACTOR'S OR LANDOWNER'S CERTIFICATION: This water well was 1 constructed, (2) reconstructed, or (3) plugged under my jurisdiction and was completed on (mo/day/year) 10/6/98 and this record is true to the best of my knowledge and belief. Kansas Water Well Contractor's License No. 565 This Water Well Record was completed on (mo/day/yr) 11/10/98 under the business name of FleerMax Drilling LLC by (signature) David Sengler

OFFICE USE ONLY