


1 LOCATION OF WATER WELL: Fraction NW 1/4 NW 1/4 SE 1/4 Section Number 17 Township Number T 23 S Range Number R 1 EW
 County: Harvey

Distance and direction from nearest town or city street address of well if located within city?
127 E. 6th Newton, Kansas

2 WATER WELL OWNER: Michael Enz
 RR#, St. Address, Box #: 1120 Columbus Ct. Board of Agriculture, Division of Water Resources
 City, State, ZIP Code: Newton, Kansas 67114 Application Number:

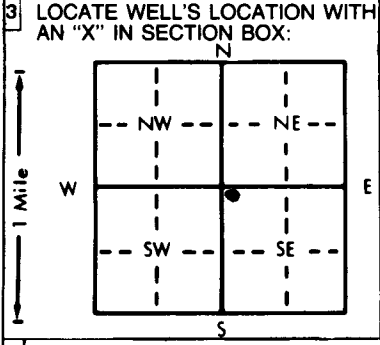

4 DEPTH OF COMPLETED WELL: 13' ft. ELEVATION:
 Depth(s) Groundwater Encountered 1.8' ft. 2. ft. 3. ft.
 WELL'S STATIC WATER LEVEL 8.27 ft. below land surface measured on mo/day/yr 10-13-98
 Pump test data: Well water was ft. after hours pumping gpm
 Est. Yield gpm: Well water was ft. after hours pumping gpm
 Bore Hole Diameter: 8 1/2" in. to 13' ft., and in. to ft.
 WELL WATER TO BE USED AS:
 5 Public water supply 8 Air conditioning 11 Injection well
 1 Domestic 3 Feedlot 6 Oil field water supply 9 Dewatering 12 Other (Specify below)
 2 Irrigation 4 Industrial 7 Lawn and garden only 10 Monitoring well
 Was a chemical/bacteriological sample submitted to Department? Yes.....No X.....; If yes, mo/day/yr sample was submitted
 Water Well Disinfected? Yes No

5 TYPE OF BLANK CASING USED:
 1 Steel 3 RMP (SR) 5 Wrought iron 8 Concrete tile CASING JOINTS: Glued.....Clamped.....
2 PVC 4 ABS 7 Fiberglass 9 Other (specify below) Welded.....
 Blank casing diameter 2.375 in. to 4' ft., Dia. in. to in. to in. to ft.
 Casing height above land surface Flush Mt. in., weight lbs./ft. Wall thickness or gauge No. SDR-13 Sch 40
 TYPE OF SCREEN OR PERFORATION MATERIAL:
 1 Steel 3 Stainless steel 5 Fiberglass 8 RMP (SR) 11 Other (specify)
 2 Brass 4 Galvanized steel 6 Concrete tile 9 ABS 12 None used (open hole)
 SCREEN OR PERFORATION OPENINGS ARE:
 1 Continuous slot 3 Mill slot 5 Gauzed wrapped 8 Saw cut 11 None (open hole)
 2 Louvered shutter 4 Key punched 6 Wire wrapped 9 Drilled holes
 7 Torch cut 10 Other (specify)
 SCREEN-PERFORATED INTERVALS: From 13' ft. to 4' ft., From ft. to ft. to ft.
 From ft. to ft. to ft. to ft. to ft.
 GRAVEL PACK INTERVALS: From 13' ft. to 3' ft., From ft. to ft. to ft.
 From ft. to ft. to ft. to ft. to ft.

6 GROUT MATERIAL: 1 Neat cement 2 Cement grout 3 Bentonite 4 Other
 Grout Intervals: From 3' ft. to 2' ft., From 2' ft. to 0' ft., From ft. to ft. to ft.
 What is the nearest source of possible contamination:
 1 Septic tank 4 Lateral lines 7 Pit privy 11 Fuel storage FUEL 14 Abandoned water well
 2 Sewer lines 5 Cess pool 8 Sewage lagoon 12 Fertilizer storage 15 Oil well/Gas well
 3 Watertight sewer lines 6 Seepage pit 9 Feedyard 13 Insecticide storage 16 Other (specify below)
 Direction from well? South Southeast How many feet? 75'

FROM	TO	LITHOLOGIC LOG	FROM	TO	PLUGGING INTERVALS
0	1	Concrete, fill sand			
1	6	Sandy clay, olive/brown, dry, hard, mottled, caliche, sl odor			
6	13	Limestone-bedrock, weathered shale partings.			
		B.O.H 13'			
					Fl.mt. OK'D by Don Taylor

7 CONTRACTOR'S OR LANDOWNER'S CERTIFICATION: This water well was (1) constructed, (2) reconstructed, or (3) plugged under my jurisdiction and was completed on (mo/day/year) 9-29-98 and this record is true to the best of my knowledge and belief. Kansas Water Well Contractor's License No. 539 This Water Well Record was completed on (mo/day/yr) 11-4-98 under the business name of JB Environmental Drilling by (signature) James Becker

OFFICE USE ONLY

T

R

EW

SEC

1/4

1/4

1/4