


1 LOCATION OF WATER WELL: County: Harvey Fraction NW 1/4 NW 1/4 SE 1/4 Section Number 17 Township Number T 23 S Range Number R 1 EW

Distance and direction from nearest town or city street address of well if located within city?
127 E. 6th; Newton Ks

2 WATER WELL OWNER: Michael Ete
RR#, St. Address, Box #: 1120 Columbus Ct.
City, State, ZIP Code: Newton, Ks 67114
Board of Agriculture, Division of Water Resources
Application Number:

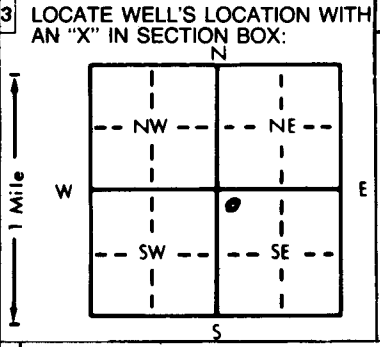

4 DEPTH OF COMPLETED WELL: 13' ft. ELEVATION: _____ ft.
Depth(s) Groundwater Encountered 19' ft. 2. _____ ft. 3. _____ ft.
WELL'S STATIC WATER LEVEL: 9.15' ft. below land surface measured on mo/day/yr 10-13-98
Pump test data: Well water was _____ ft. after _____ hours pumping _____ gpm
Est. Yield _____ gpm; Well water was _____ ft. after _____ hours pumping _____ gpm
Bore Hole Diameter: 8 1/2" in. to 13" ft., and _____ in. to _____ ft.
WELL WATER TO BE USED AS: 5 Public water supply 8 Air conditioning 11 Injection well
1 Domestic 3 Feedlot 6 Oil field water supply 9 Dewatering 12 Other (Specify below)
2 Irrigation 4 Industrial 7 Lawn and garden only 10 Monitoring well
Was a chemical/bacteriological sample submitted to Department? Yes _____ No X; If yes, mo/day/yr sample was submitted _____
Water Well Disinfected? Yes _____ No X

5 TYPE OF BLANK CASING USED: 1 Steel 3 RMP (SR) 5 Wrought iron 8 Concrete tile CASING JOINTS: Glued _____ Clamped _____
2 PVC 4 ABS 6 Asbestos-Cement 9 Other (specify below) Welded _____
Blank casing diameter: 2.375 in. to 4" ft., Dia _____ in. to _____ ft., Dia _____ in. to _____ ft.
Casing height above land surface: Flush Me. in., weight _____ lbs./ft. Wall thickness or gauge No. SDR-13
TYPE OF SCREEN OR PERFORATION MATERIAL: 7 PVC 10 Asbestos-cement Sch 40
1 Steel 3 Stainless steel 5 Fiberglass 8 RMP (SR) 11 Other (specify) _____
2 Brass 4 Galvanized steel 6 Concrete tile 9 ABS 12 None used (open hole)
SCREEN OR PERFORATION OPENINGS ARE: 5 Gauzed wrapped 8 Saw cut 11 None (open hole)
1 Continuous slot 3 Mill slot 6 Wire wrapped 9 Drilled holes
2 Louvered shutter 4 Key punched 7 Torch cut 10 Other (specify) _____
SCREEN-PERFORATED INTERVALS: From 13' ft. to 4' ft., From _____ ft. to _____ ft.
GRAVEL PACK INTERVALS: From 13' ft. to 3' ft., From _____ ft. to _____ ft.

6 GROUT MATERIAL: 1 Neat cement 2 Cement grout 3 Bentonite 4 Other _____
Grout Intervals: From 3' ft. to 2' ft., From 2' ft. to 0' ft., From _____ ft. to _____ ft.
What is the nearest source of possible contamination: 1 Septic tank 4 Lateral lines 7 Pit privy 11 Fuel storage 15 Oil well/Gas well
2 Sewer lines 5 Cess pool 8 Sewage lagoon 12 Fertilizer storage 16 Other (specify below)
3 Watertight sewer lines 6 Seepage pit 9 Feedyard 13 Insecticide storage
Direction from well? Northwest How many feet? 140'

FROM	TO	LITHOLOGIC LOG	FROM	TO	PLUGGING INTERVALS
0	1.0	Wood chips			
1.0	7.0	dk brn - Bgn sandy clay, firm, moist Hottel, odor			
7.0	8.0	slue Bgn, sandy clay, moist, calcike odor			
8.0	10.0	gray shale, moist, friable			
10.0	13.0	Limestone			

F.H. OK'd by N. Taylor

7 CONTRACTOR'S OR LANDOWNER'S CERTIFICATION: This water well was (1) constructed (2) reconstructed, or (3) plugged under my jurisdiction and was completed on (mo/day/year) 9-29-98 and this record is true to the best of my knowledge and belief. Kansas Water Well Contractor's License No. 539 This Water Well Record was completed on (mo/day/yr) 11-4-98 under the business name of JB Environmental Drilling by (signature) James Bieber

OFFICE USE ONLY

T

R

EW

SEC

1/4

1/4

1/4