


1

1 LOCATION OF WATER WELL: County: HAWKEY Fraction: NW 1/4 NW 1/4 SE 1/4 Section Number: 17 Township Number: T 23 S Range Number: R 1 E

Distance and direction from nearest town or city street address of well if located within city?  
127 E. 6th, Newton, KS

2 WATER WELL OWNER: Mike Eaz  
 RR#, St. Address, Box #: 1120 Columbus Ct. Board of Agriculture, Division of Water Resources  
 City, State, ZIP Code: Newton, KS Application Number:

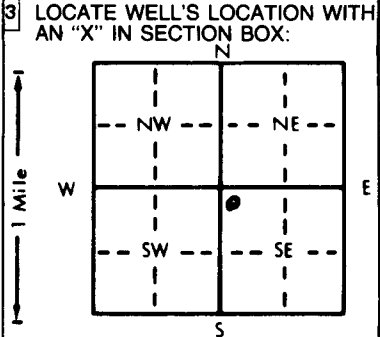

4 DEPTH OF COMPLETED WELL: 13' ft. ELEVATION: ..... ft.  
 Depth(s) Groundwater Encountered 1. 8' ft. 2. .... ft. 3. .... ft.  
 WELL'S STATIC WATER LEVEL: 7.37 ft. below land surface measured on mo/day/yr 10-13-98  
 Pump test data: Well water was ..... ft. after ..... hours pumping ..... gpm  
 Est. Yield ..... gpm; Well water was ..... ft. after ..... hours pumping ..... gpm  
 Bore Hole Diameter: 8 1/2" in. to 13" ft., and ..... in. to ..... ft.  
 WELL WATER TO BE USED AS:  
 5 Public water supply 8 Air conditioning 11 Injection well  
 1 Domestic 3 Feedlot 6 Oil field water supply 9 Dewatering 12 Other (Specify below)  
 2 Irrigation 4 Industrial 7 Lawn and garden only  Monitoring well  
 Was a chemical/bacteriological sample submitted to Department? Yes ..... No ; If yes, mo/day/yr sample was submitted  
 Water Well Disinfected? Yes ..... No

5 TYPE OF BLANK CASING USED:  
 1 Steel 3 RMP (SR) 5 Wrought iron 8 Concrete tile CASING JOINTS: Glued ..... Clamped .....  
 2 PVC 4 ABS 6 Asbestos-Cement 9 Other (specify below) Welded .....  
 7 Fiberglass Threaded .....  
 Blank casing diameter 2.315 in. to 3' ft., Dia ..... in. to ..... ft., Dia ..... in. to ..... ft.  
 Casing height above land surface Flush Ht. in., weight ..... lbs./ft. Wall thickness or gauge No. Sch 40  
 TYPE OF SCREEN OR PERFORATION MATERIAL:  7 PVC 10 Asbestos-cement SOR-13  
 1 Steel 3 Stainless steel 5 Fiberglass 8 RMP (SR) 11 Other (specify) .....  
 2 Brass 4 Galvanized steel 6 Concrete tile 9 ABS 12 None used (open hole)  
 SCREEN OR PERFORATION OPENINGS ARE:  
 1 Continuous slot  3 Mill slot 5 Gauzed wrapped 8 Saw cut 11 None (open hole)  
 2 Louvered shutter 4 Key punched 6 Wire wrapped 9 Drilled holes  
 7 Torch cut 10 Other (specify) .....  
 SCREEN-PERFORATED INTERVALS: From 13' ft. to 3' ft., From ..... ft. to ..... ft.  
 From ..... ft. to ..... ft., From ..... ft. to ..... ft.  
 GRAVEL PACK INTERVALS: From 13' ft. to 2 1/2' ft., From ..... ft. to ..... ft.  
 From ..... ft. to ..... ft., From ..... ft. to ..... ft.

6 GROUT MATERIAL: 1 Neat cement 2 Cement grout 3 Bentonite 4 Other .....  
 Grout Intervals: From 2 1/2' to 1 1/2' ft., From 1 1/2' to 0' ft., From ..... ft. to ..... ft.  
 What is the nearest source of possible contamination:  
 1 Septic tank 4 Lateral lines 7 Pit privy  11 Fuel storage Fuel 14 Abandoned water well  
 2 Sewer lines 5 Cess pool 8 Sewage lagoon 12 Fertilizer storage 15 Oil well/Gas well  
 3 Watertight sewer lines 6 Seepage pit 9 Feedyard 13 Insecticide storage 16 Other (specify below)

Direction from well? In old Pit How many feet? 0

FROM	TO	LITHOLOGIC LOG	FROM	TO	PLUGGING INTERVALS
0	1.0	Concrete			
1.0	5.0	DK Br-Bn sandy clay, moist, firm clay, slight collapse			
5.0	9.5	Blay high cond clay, wet ab 8' yellow, calcined			
9.5	13.0	Br-Bn shale, weathered friable			
13.0	—	limestone			

F.H. OK'd by N. Taylor

7 CONTRACTOR'S OR LANDOWNER'S CERTIFICATION: This water well was (1)  constructed, (2) reconstructed, or (3) plugged under my jurisdiction and was completed on (mo/day/year) 4-29-98 and this record is true to the best of my knowledge and belief. Kansas Water Well Contractor's License No. 539 This Water Well Record was completed on (mo/day/yr) 11-4-98 under the business name of JB Environmental Drilling by (signature) James Belker

OFFICE USE ONLY  
T  
R  
EW  
SEC