

CORRECTION TO WATER WELL RECORD (WWC-5)

The following correction(s) was made to the attached WWC-5 log, in order to file the item or to rectify lacking or incorrect information.

Fraction (1/4 1/4 1/4) Section-Township-Range changed:

listed as _____

changed to _____

Other changes: Initial statements: _____

Changed to: _____

Comments: The corrections in red on the form are correct. Well MW-4 is on the other side of 12th St. (South) from well owner's establishment, in a Dillon's parking lot. (Also see other well records in SW1/4SE, 8-235-1E)
verification method: Phone call to well owner, well owner's address, Newton city map, & Newton 1:24,000 topo map. initials: OP date: 3/6/2001


submitted by: Kansas Geological Survey, Data Resources Library, 1930 Constant Ave., Lawrence, KS 66047-3726
to: Kansas Dept of Health & Environment Bureau of Water Industrial Programs, Bldg 283, Forbes Field, KS 66620

WATER WELL RECORD Form WWC-5 KSA 82a-1212

LOCATION OF WATER WELL: Fraction NW NW NE Section Number 17 Township Number T 23 S Range Number R 1 EW

County Harvey Distance and direction from nearest town or city street address of well if located within city: 1300 North Main Newton, KS MW-4

WATER WELL OWNER: The Service Station Board of Agriculture, Division of Water Resources
 P.O. or St. Address, Box #: 1300 N Main Application Number:
 City, State, ZIP Code: Newton KS

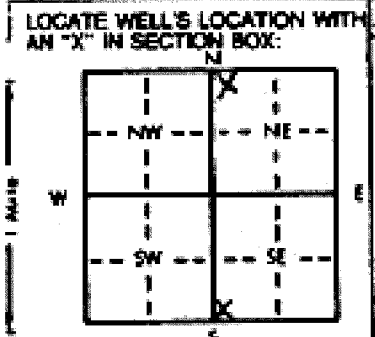

DEPTH OF COMPLETED WELL: 15 ft. ELEVATION: 1122.25

Depth(s) Groundwater Encountered 1. 10 ft. 2. _____ ft. 3. _____ ft.

WELL'S STATIC WATER LEVEL: 6.83 ft. below land surface measured on 11/10/98

Pump test data: Well water was _____ ft. after _____ hours pumping _____ gpm

Est. Yield _____ gpm: Well water was _____ ft. after _____ hours pumping _____ gpm

Bore Hole Diameter 8 in. to 15 in. and _____ in. to _____ in.

WELL WATER TO BE USED AS: 5 Public water supply 8 Air conditioning 11 Injection well
 1 Domestic 3 Feedlot 8 Oil field water supply 9 Dewatering 12 Other (Specify below)
 2 Irrigation 4 Industrial 7 Lawn and garden only 10 Monitoring well

Was a chemical/bacteriological sample submitted to Department? Yes No: If yes, mo/day/yr sample was submitted _____
 Water Well Disinfected? Yes No

TYPE OF BLANK CASING USED: 1 Steel 3 RMP (SR) 5 Wrought iron 8 Concrete tile CASING JOINTS: Glued _____ Clamped _____
 2 PVC 4 ABS 6 Asbestos-Cement 9 Other (specify below) Welded _____
 7 Fiberglass _____ Threaded Threaded

Blank casing diameter 2 in. to 5 ft. Dia _____ in. to _____ ft. Dia _____ in. to _____ ft.

Casing height above land surface _____ in., weight _____ lbs./ft. Wall thickness or gauge No. _____

TYPE OF SCREEN OR PERFORATION MATERIAL: 1 Steel 3 Stainless steel 5 Fiberglass 8 RMP (SR) 10 Asbestos-cement
 2 Brass 4 Galvanized steel 6 Concrete tile 9 ABS 11 Other (specify) _____
 12 None used (open hole)

SCREEN OR PERFORATION OPENINGS ARE: 1 Continuous slot 3 3/8" slot 5 Gauzed wrapped 8 Saw cut 11 None (open hole)
 2 Louvered shutter 4 Key punched 6 Wire wrapped 9 Drilled holes
 7 Torch out 10 Other (specify) _____

SCREEN-PERFORATED INTERVALS: From 5 ft. to 15 ft. From _____ ft. to _____ ft.
 From _____ ft. to _____ ft. From _____ ft. to _____ ft.

GRAVEL PACK INTERVALS: From 4 ft. to 15 ft. From _____ ft. to _____ ft.
 From _____ ft. to _____ ft. From _____ ft. to _____ ft.

GROUT MATERIAL: 1 Neat cement 2 Cement grout 3 Bentonite 4 Other CASING

Grout intervals: From 4 ft. to 1 ft. From 1 ft. to 0 ft. From _____ ft. to _____ ft.

What is the nearest source of possible contamination: 1 Septic tank 4 Lateral lines 7 PR privy 10 Livestock pens 14 Abandoned water well
 2 Sewer lines 5 Cess pool 8 Sewage lagoon 11 Fuel storage 15 Oil well/Gas well
 3 Watertight sewer lines 6 Seepage pit 9 Feedyard 12 Fertilizer storage 16 Other (specify below)
 13 Insecticide storage

Direction from well? North How many feet? 100

FROM	TO	LITHOLOGIC LOG	FROM	TO	PLUGGING INTERVALS
0	2"	Reput			
2"	4"	Casing			
4"	1'	Sand			
1'	7.5'	Clay w/ sand brown			
7.5'	10.0'	Clay w/ sand brown			
10.0'	15.0'	Clay w/ sand brown, wet			

RECEIVED
 FEB 08 1999
 BUREAU OF WATER

CONTRACTOR'S OR LANDOWNER'S CERTIFICATION: This water well was (1) constructed, (2) reconstructed, or (3) plugged under my jurisdiction and was completed on (mo/day/yr) 10/21/98 and this record is true to the best of my knowledge and belief. Kansas Water Well Contractor's License No. 565 This Water Well Record was completed on (mo/day/yr) 11/10/98 by (signature) [Signature] under the business name of [Signature]

NOTE: (1) (2) (3) Use in order of fill only. PLEASE PRESS FIRMLY and PRINT clearly. Please fill in blanks, underline or circle the correct answers. Send top 3/4 copies to Kansas Department