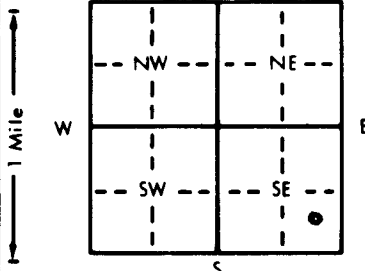


1 LOCATION OF WATER WELL: County: <u>Harvey</u>		Fraction <u>NE</u> $\frac{1}{4}$ <u>SE</u> $\frac{1}{4}$ <u>SE</u> $\frac{1}{4}$	Section Number <u>20</u>	Township Number T <u>23</u> S	Range Number R <u>1</u> <u>EW</u>
Distance and direction from nearest town or city street address of well if located within city? <u>1205 Washington Rd., Newton, KS.</u>					
2 WATER WELL OWNER: RR#, St. Address, Box # : City, State, ZIP Code		Gertrude Watts/Southside Svce. <u>1205 Washington Rd.</u> <u>Newton, KS.</u>			
		Board of Agriculture, Division of Water Resources Application Number:			
3 LOCATE WELL'S LOCATION WITH AN "X" IN SECTION BOX: <div style="text-align: center;"></div>		4 DEPTH OF COMPLETED WELL: <u>18 1/2'</u> ft. ELEVATION: Depth(s) Groundwater Encountered 1. <u>13'</u> ft. 2. ft. 3. ft. WELL'S STATIC WATER LEVEL <u>12.98</u> ft. below land surface measured on mo/day/yr <u>2-16-99</u> Pump test data: Well water was ft. after hours pumping gpm Est. Yield gpm: Well water was ft. after hours pumping gpm Bore Hole Diameter <u>8 1/2"</u> in. to <u>18 1/2"</u> ft. and in. to ft. WELL WATER TO BE USED AS: 5 Public water supply 8 Air conditioning 11 Injection well 1 Domestic 3 Feedlot 6 Oil field water supply 9 Dewatering 12 Other (Specify below) 2 Irrigation 4 Industrial 7 Lawn and garden only 10 Monitoring well Was a chemical/bacteriological sample submitted to Department? Yes No <u>X</u> ; If yes, mo/day/yr sample was submitted Water Well Disinfected? Yes <u>No</u>			
5 TYPE OF BLANK CASING USED: 1 Steel <u>2 PVC</u> Blank casing diameter <u>2.375</u> in. to <u>8 1/2'</u> ft. Dia. in. to ft. Dia. in. to ft. Casing height above land surface <u>Flush ft.</u> in. weight lbs./ft. Wall thickness or gauge No. <u>SCF 40</u>		5 Wrought iron 8 Concrete tile CASING JOINTS: Glued Clamped 6 Asbestos-Cement 9 Other (specify below) Welded 7 Fiberglass Threaded			
TYPE OF SCREEN OR PERFORATION MATERIAL: 1 Steel 3 Stainless steel 5 Fiberglass 8 RMP (SR) 11 Other (specify) 2 Brass 4 Galvanized steel 6 Concrete tile 9 ABS 12 None used (open hole)		7 PVC 10 Asbestos-cement			
SCREEN OR PERFORATION OPENINGS ARE: 1 Continuous slot 3 Mill slot 5 Gauzed wrapped 8 Saw cut 11 None (open hole) 2 Louvered shutter 4 Key punched 6 Wire wrapped 9 Drilled holes		7 Torch cut 10 Other (specify)			
SCREEN-PERFORATED INTERVALS: From <u>18 1/2'</u> ft. to <u>8 1/2'</u> ft. From ft. to ft. From ft. to ft. From ft. to ft.					
GRAVEL PACK INTERVALS: From <u>18 1/2'</u> ft. to <u>6 1/2'</u> ft. From ft. to ft. From ft. to ft. From ft. to ft.					
6 GROUT MATERIAL: 1 Neat cement 2 Cement grout 3 Bentonite 4 Other Grout Intervals: From <u>6 1/2'</u> ft. to <u>3'</u> ft. From <u>3'</u> ft. to <u>0'</u> ft. From ft. to ft.					
What is the nearest source of possible contamination: 1 Septic tank 4 Lateral lines 7 Pit privy 10 Livestock pens 14 Abandoned water well 2 Sewer lines 5 Cess pool 8 Sewage lagoon 11 Fuel storage 15 Oil well/Gas well 3 Watertight sewer lines 6 Seepage pit 9 Feedyard 12 Fertilizer storage 16 Other (specify below) 13 Insecticide storage					
Direction from well? <u>North</u>		How many feet? <u>70'</u>			
FROM	TO	LITHOLOGIC LOG	FROM	TO	PLUGGING INTERVALS
0	.50	Asphalt			
.50	3	Dk brn silty sandy clay, drv, firm, no odor.			
3	5.25	Dk gray to green gray mottled clay, slight odor, firm to stiff, moist.			
5.25	8	Red brn sandy clay to clayey sand w/dk gray sand stringers, damp, sli to mod. odor.			
8	15	Grayish brn fine-coarse sand, dry, moist to wet at 13'.			Fl.mt. ok'd by Don Taylor
15	18.50	Gray shaley clay, moist, stiff, slight odor.			
7 CONTRACTOR'S OR LANDOWNER'S CERTIFICATION: This water well was (1) constructed (2) reconstructed, or (3) plugged under my jurisdiction and was completed on (mo/day/year) <u>2-16-99</u> and this record is true to the best of my knowledge and belief. Kansas Water Well Contractor's License No. <u>539</u> This Water Well Record was completed on (mo/day/yr) <u>2-19-99</u> under the business name of <u>JB Environmental Drilling</u> by (signature) <u>James Becker</u>					
INSTRUCTIONS: Use typewriter or ball point pen. PLEASE PRESS FIRMLY and PRINT clearly. Please fill in blanks, underline or circle the correct answers. Send top three copies to Kansas Department of Health and Environment, Bureau of Water, Topeka, Kansas 66620-0001. Telephone: 913-296-5545. Send one to WATER WELL OWNER and retain one for your records.					