

CORRECTION(S) TO WATER WELL RECORD (WWC-5)  
(to rectify lacking or incorrect information)

County: Harvey

Location listed as:

Location changed to:

Section-Township-Range: 15-23 S-1 E

5-23 S-1 E

Fraction (  $\frac{1}{4}$   $\frac{1}{4}$   $\frac{1}{4}$ ): SW SW SW

SW SW SW

Other changes: Initial statements: \_\_\_\_\_

Changed to: \_\_\_\_\_

Comments: \_\_\_\_\_

verification method: Notification by contractor working for well owner,  
well address, city street map, and mapping tool on  
KGS website. initials: WRD date: 4/10/2008


1 LOCATION OF WATER WELL: County: Harvey Fraction: SW 1/4 SW 1/4 Section Number: 15 Township Number: T 23 S Range Number: R 1  E/W

Distance and direction from nearest town or city street address of well if located within city? 2800 N. old itury st, Newton KS

2 WATER WELL OWNER: Prestressed Concrete  
 RR#, St. Address, Box #: c/o GSI 4303 E 4th St. Board of Agriculture, Division of Water Resources  
 City, State, ZIP Code: Wichita KS 67210 Application Number:

3 LOCATE WELL'S LOCATION WITH AN "X" IN SECTION BOX:

4 DEPTH OF COMPLETED WELL: 101 ft. ELEVATION:

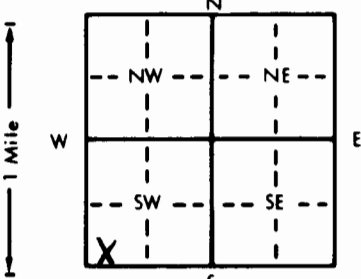

Depth(s) Groundwater Encountered 1. 17 ft. 2. . ft. 3. . ft.  
 WELL'S STATIC WATER LEVEL . ft. below land surface measured on mo/day/yr  
 Pump test data: Well water was . ft. after . hours pumping . gpm  
 Est. Yield . gpm: Well water was . ft. after . hours pumping . gpm  
 Bore Hole Diameter ~~8.75~~ 10 in. to ~~4~~ 4.5 ft., and 6 in. to 101 ft.  
 WELL WATER TO BE USED AS:  
 1 Domestic 3 Feedlot 6 Oil field water supply 9 Dewatering 11 Injection well  
 2 Irrigation 4 Industrial 7 Lawn and garden only  10 Monitoring well 12 Other (Specify below)  
 Was a chemical/bacteriological sample submitted to Department? Yes . No ; If yes, mo/day/yr sample was submitted  
 Water Well Disinfected? Yes . No

5 TYPE OF BLANK CASING USED:  
 1 Steel 3 RMP (SR) 5 Wrought iron 8 Concrete tile CASING JOINTS: Glued . Clamped .  
 2 PVC 4 ABS 6 Asbestos-Cement 9 Other (specify below) Welded .  
 7 Fiberglass Threaded .

Blank casing diameter 2 in. to 61 ft., Dia . in. to . ft., Dia . in. to . ft.  
 Casing height above land surface 0 in., weight sch. 40 lbs./ft. Wall thickness or gauge No. .

TYPE OF SCREEN OR PERFORATION MATERIAL:  
 1 Steel 3 Stainless steel 5 Fiberglass 8 RMP (SR) 11 Other (specify) .  
 2 Brass 4 Galvanized steel 6 Concrete tile 9 ABS 12 None used (open hole)

SCREEN OR PERFORATION OPENINGS ARE:  
 1 Continuous slot  3 Mill slot 5 Gauzed wrapped 8 Saw cut 11 None (open hole)  
 2 Louvered shutter 4 Key punched 6 Wire wrapped 9 Drilled holes  
 7 Torch cut 10 Other (specify) .

SCREEN-PERFORATED INTERVALS: From 61 ft. to 101 ft., From . ft. to . ft.  
 From . ft. to . ft., From . ft. to . ft.  
 GRAVEL PACK INTERVALS: From 60 ft. to 101 ft., From . ft. to . ft.  
 From . ft. to . ft., From . ft. to . ft.

6 GROUT MATERIAL:  1 Neat cement 2 Cement grout  3 Bentonite 4 Other .  
 Grout Intervals: From 0 ft. to 60 ft., From . ft. to . ft., From . ft. to . ft.

What is the nearest source of possible contamination:  
 1 Septic tank 4 Lateral lines 7 Pit privy 10 Livestock pens 14 Abandoned water well  
 2 Sewer lines 5 Cess pool 8 Sewage lagoon 11 Fuel storage 15 Oil well/Gas well  
 3 Watertight sewer lines 6 Seepage pit 9 Feedyard 12 Fertilizer storage 16 Other (specify below)  
 13 Insecticide storage

Direction from well? How many feet?

FROM	TO	LITHOLOGIC LOG	FROM	TO	PLUGGING INTERVALS
0	1.0	concrete fill			
1.0	10.0	Silty clay (CH)	90	92	mudstone
10.0	17.0	clayey silt (ml)	92	93	shale
17.0	21.0	sand (SP)	93	97	mudstone
21.0	24.0	silt (mg)	97	101	shale
24.0	27.0	sand (SP)	TD	101	End of Borehole
27.0	32.0	Silty clay (CL)			
32.0	35.0	sand (SW)			
35.0	41.0	silty clay (CL)			
41.0	63.0	Shale			
63.0	64.0	Mudstone			
64.0	68.0	Shale			
68.0	69.00	Gypsum			
69.0	88.0	Shale			
88.0	90.0	shale w/gypsum			

7 CONTRACTOR'S OR LANDOWNER'S CERTIFICATION: This water well was  (1) constructed, (2) reconstructed, or (3) plugged under my jurisdiction and was completed on (mo/day/year) 3/3/00 and this record is true to the best of my knowledge and belief. Kansas Water Well Contractor's License No. 585 This Water Well Record was completed on (mo/day/yr) 3/9/00 under the business name of ATEL by (signature) D. Johnson for D. Deane

OFFICE USE ONLY T R E/W SEC. 1/4 1/4 1/4