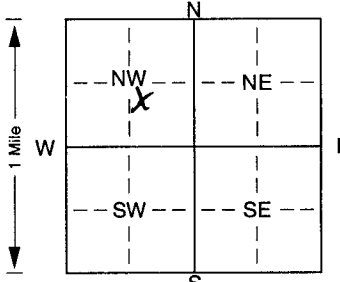


1] LOCATION OF WATER WELL: Fraction NW 1/4 SE 1/4 NW 1/4 Section Number 8 Township Number T 23 S R 1 Range Number EW
 County: Harvey

Distance and direction from nearest town or city street address of well if located within city?
2013 Clover Ln in Newton

2] WATER WELL OWNER: Hellen Willard
 RR#, St. Address, Box #: 2013 Clover Ln Board of Agriculture, Division of Water Resources
 City, State, ZIP Code: Newton, KS 67114 Application Number:

3] LOCATE WELL'S LOCATION WITH AN "X" IN SECTION BOX:

 4] DEPTH OF COMPLETED WELL: 78 ft. ELEVATION:
 Depth(s) Groundwater Encountered 1. 18 ft. 2. 39 ft. 3. 5 1/2 ft.
 WELL'S STATIC WATER LEVEL 18 ft. below land surface measured on mo/day/yr 8-3-00
 Pump test data: Well water was 39 ft. after 1 hours pumping 25 gpm
 Est. Yield 25 gpm: Well water was 39 ft. after 1 hours pumping 25 gpm
 Bore Hole Diameter: 9 in. to 38 ft., and 5 1/2 in. to 78 ft.
 WELL WATER TO BE USED AS:
 5 Public water supply 8 Air conditioning 11 Injection well
 1 Domestic 3 Feedlot 6 Oil field water supply 9 Dewatering 12 Other (Specify below)
 2 Irrigation 4 Industrial 7 Domestic (lawn & garden) 10 Monitoring well
 Was a chemical/bacteriological sample submitted to Department? Yes. X No. X; If yes, mo/day/yr sample was submitted
 Water Well Disinfected? Yes X No X

5] TYPE OF BLANK CASING USED:
 1 Steel 3 RMP (SR) 5 Wrought iron 8 Concrete tile CASING JOINTS: Glued X Clamped X
2 PVC 4 ABS 6 Asbestos-Cement 9 Other (specify below) Welded X
 7 Fiberglass Threaded X
 Blank casing diameter 6 in. to 38 ft., Dia 6 in. to 38 ft., Dia 6 in. to 38 ft.
 Casing height above land surface 12 in., weight 2.29 lbs./ft. Wall thickness or gauge No. 160
 TYPE OF SCREEN OR PERFORATION MATERIAL:
 1 Steel 3 Stainless steel 5 Fiberglass 2 PVC 10 Asbestos-cement
 2 Brass 4 Galvanized steel 6 Concrete tile 8 RMP (SR) 11 Other (specify) 12 None used (open hole)
 9 ABS
 SCREEN OR PERFORATION OPENINGS ARE:
 1 Continuous slot 3 Mill slot 5 Gauzed wrapped 1 Saw cut 11 None (open hole)
 2 Louvered shutter 4 Key punched 6 Wire wrapped 9 Drilled holes
 7 Torch cut 10 Other (specify) 11 None (open hole)
 SCREEN-PERFORATED INTERVALS: From 0 ft. to 29 ft., From 29 ft. to 32 ft., From 32 ft. to 78 ft.
 GRAVEL PACK INTERVALS: From 0 ft. to 29 ft., From 29 ft. to 32 ft., From 32 ft. to 78 ft.

6] GROUT MATERIAL: 1 Neat cement 2 Cement grout 3 Bentonite 4 Other 3
 Grout Intervals: From 2 ft. to 22 ft., From 33 ft. to 38 ft., From 38 ft. to 78 ft.
 What is the nearest source of possible contamination:
 1 Septic tank 4 Lateral lines 7 Pit privy 10 Livestock pens 14 Abandoned water well
 2 Sewer lines 5 Cess pool 8 Sewage lagoon 11 Fuel storage 15 Oil well/Gas well
3 Watertight sewer lines 6 Seepage pit 9 Feedyard 12 Fertilizer storage 16 Other (specify below)
 13 Insecticide storage
 Direction from well? E How many feet? 35

FROM	TO	LITHOLOGIC LOG	FROM	TO	PLUGGING INTERVALS
<u>0</u>	<u>29</u>	<u>Br Clay</u>			
<u>29</u>	<u>32</u>	<u>M Sand</u>			
<u>32</u>	<u>78</u>	<u>Shale</u>			

7] CONTRACTOR'S OR LANDOWNER'S CERTIFICATION: This water well was 1 constructed, (2) reconstructed, or (3) plugged under my jurisdiction and was completed on (mo/day/year) 8-3-00 and this record is true to the best of my knowledge and belief. Kansas Water Well Contractor's Licence No. 447. This Water Well Record was completed on (mo/day/yr) 8-22-00 under the business name of Miller Drilling by (signature) [Signature]