


1 LOCATION OF WATER WELL:	Fraction	Section Number	Township Number	Range Number
County: <u>Harvey</u>	<u>SW¹/₄ SE¹/₄ NW¹/₄</u>	<u>17</u>	<u>23</u>	<u>1-E</u>

Distance and direction from nearest town or city street address of well if located within city?
300 W Broadway Newton, Ks MW#3

2 WATER WELL OWNER: <u>DOISEY BAKRI</u>	Board of Agriculture, Division of Water Resources
RR #, St. Address, Box #: <u>300 W Broadway</u>	Application Number:
City, State, ZIP Code : <u>Newton, Ks 67114</u>	

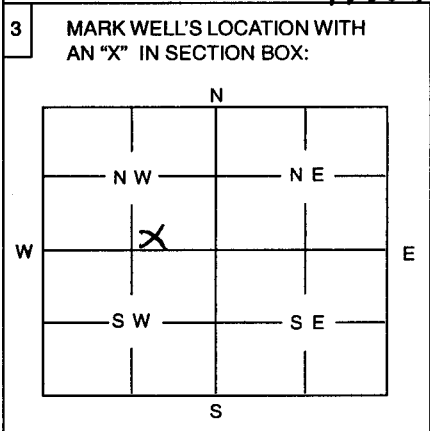

4 DEPTH OF WELL 13.5 ft

WELL'S STATIC WATER LEVEL 6 ft.

WELL WAS USED AS:

1 Domestic	5 Public Water Supply	9 Dewatering
2 Irrigation	6 Oil Field Water Supply	<input checked="" type="radio"/> Monitoring Well
3 Feedlot	7 Domestic (Lawn & Garden)	11 Injection Well
4 Industrial	8 Air Conditioning	12 Other

Was a chemical / bacteriological sample submitted to Department? Yes No

If yes, mo/day/yr sample was submitted

Water Well Disinfected: Yes No

5 TYPE OF BLANK CASING USED:

1 Steel	3 RMP (SR)	5 Wrought	7 Fiberglass	9 Other (Specify below)
<input checked="" type="radio"/> PVC	4 ABS	6 Asbestos-Cement	8 Concrete Tile	

Blank casing diameter 2 in. Was casing pulled? Yes No If yes, how much 3.5'

Casing height above or below land surface in.

6 GROUT PLUG MATERIAL: 1 Neat cement 2 Cement grout Bentonite 4 Other Quickcrete

Grout Plug Intervals: From ft. to ft., From 13.5 ft. to -1.6 ft., From -1.6 to 0 ft.

What is the nearest source of possible contamination:

1 Septic tank	6 Seepage pit	<input checked="" type="radio"/> Fuel storage	16 Other (specify below)
2 Sewer lines	7 Pit privy	12 Fertilizer storage	
3 Watertight sewer lines	8 Sewage lagoon	13 Insecticide storage	
4 Lateral lines	9 Feedyard	14 Abandoned water well	
5 Cess Pool	10 Livestock pens	15 Oil well/Gas well	

Direction from well? North How many feet? 0

FROM	TO	PLUGGING MATERIALS
<u>13.5</u>	<u>-1.6</u>	<u>BENTONITE 3/8"</u>
<u>-1.6</u>	<u>0</u>	<u>SURFACE QUICKCRETE</u>

7 CONTRACTOR'S OR LANDOWNER'S CERTIFICATION: This water well was plugged under my jurisdiction and was completed on (mo/day/year) 9-12-00 and this record is true to the best of my knowledge and belief. Kansas Water Well Contractor's License No. 575 This Water Well Record was completed on (mo/day/year) 9-26-00 under the business name of FUNKER DRILLING SERVICE INC by (signature) Alan L. Kuntz

INSTRUCTIONS: Use typewriter or ball point pen. Please press firmly and print clearly. Please fill in blanks, underline or circle the correct answers. Send top three copies to Kansas Department of Health and Environment, Bureau of Water, Topeka, Kansas 66620-0001. Telephone: 785/296-3565. Send one to Water Well Owner and retain one for your records.