


MW#7

1	LOCATION OF WATER WELL: County: <u>Harvey</u>	Fraction <u>NE 1/4 NW 1/4 NW 1/4</u>	Section Number <u>8</u>	Township Number <u>23</u>	Range Number <u>1-E</u>
---	--	---	----------------------------	------------------------------	----------------------------

Distance and direction from nearest town or city street address of well if located within city?
24th st & Old B1 Hwy Newton, KS MW#7

2	WATER WELL OWNER: <u>Farmers Grain & Coop</u> RR #, St. Address, Box #: <u>24th & Old B1 Hwy</u> City, State, ZIP Code : <u>N. Newton KS 67114</u>	Board of Agriculture, Division of Water Resources Application Number:
---	--	--

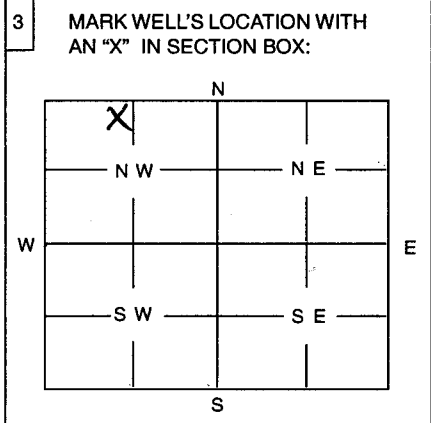

4 DEPTH OF WELL 20 ft

WELL'S STATIC WATER LEVEL _____ ft.

WELL WAS USED AS:

1 Domestic	5 Public Water Supply	9 Dewatering
2 Irrigation	6 Oil Field Water Supply	<input checked="" type="radio"/> 10 Monitoring Well
3 Feedlot	7 Domestic (Lawn & Garden)	11 Injection Well
4 Industrial	8 Air Conditioning	12 Other _____

Was a chemical / bacteriological sample submitted to Department? Yes _____ No ✓

If yes, mo/day/yr sample was submitted _____

Water Well Disinfected: Yes _____ No ✓

5 TYPE OF BLANK CASING USED:

1 Steel	3 RMP (SR)	5 Wrought	7 Fiberglass	9 Other (Specify below)
<input checked="" type="radio"/> 2 PVC	4 ABS	6 Asbestos-Cement	8 Concrete Tile	

Blank casing diameter 2 in. Was casing pulled? Yes ✓ No _____ If yes, how much 9.67

Casing height above or below land surface _____ in.

6 GROUT PLUG MATERIAL: 1 Neat cement 2 Cement grout 3 Bentonite 4 Other Top soil

Grout Plug Intervals: From _____ ft. to _____ ft., From 20 ft. to -1 ft., From -1 to 0 ft.

What is the nearest source of possible contamination:

1 Septic tank	6 Seepage pit	<input checked="" type="radio"/> 11 Fuel storage	16 Other (specify below)
2 Sewer lines	7 Pit privy	12 Fertilizer storage	
3 Watertight sewer lines	8 Sewage lagoon	13 Insecticide storage	
4 Lateral lines	9 Feedyard	14 Abandoned water well	
5 Cess Pool	10 Livestock pens	15 Oil well/Gas well	

Direction from well? South How many feet? 300

FROM	TO	PLUGGING MATERIALS
<u>20</u>	<u>-1</u>	<u>Bentonite 3/8 chps</u>
<u>-1</u>	<u>0</u>	<u>Top soil</u>

7 CONTRACTOR'S OR LANDOWNER'S CERTIFICATION: This water well was plugged under my jurisdiction and was completed on (mo/day/year) 11-29-00 and this record is true to the best of my knowledge and belief. Kansas Water Well Contractor's License No. 575 This Water Well Record was completed on (mo/day/year) 12-13-00 under the business name of FUNKER DRILLING SERVICE by (signature) [Signature]

INSTRUCTIONS: Use typewriter or ball point pen. Please press firmly and print clearly. Please fill in blanks, underline or circle the correct answers. Send top three copies to Kansas Department of Health and Environment, Bureau of Water, Topeka, Kansas 66620-0001. Telephone: 785/296-3565. Send one to Water Well Owner and retain one for your records.