

CORRECTION TO WATER WELL RECORD (WWC-5)

The following correction(s) was made to the attached WWC-5 log, in order to file the item or to rectify lacking or incorrect information.

Fraction (1/4 1/4 1/4) Section-Township-Range changed:

listed as SW SW SE, 17-23-1

changed to SW SW SE, 17-23S-1E

Other changes: Initial statements: _____

Changed to: _____

Comments: _____

verification method: Written & legal descriptions, position on plat map, Newton city map on internet, and Newton 1:24,000 topo map initials: DRS date: 5/17/2001


submitted by: Kansas Geological Survey, Data Resources Library, 1930 Constant Ave., Lawrence, KS 66047-3726
to: Kansas Dept of Health & Environment Bureau of Water Industrial Programs, Bldg 283, Forbes Field, KS 66620

MW-11

1 LOCATION OF WATER WELL: Fraction Section Number Township Number Range Number
 County: Harvey SW 1/4 SW 1/4 SE 1/4 17 23 1

Distance and direction from nearest town or city street address of well if located within city?
106'E & 44'S of SE corner of First Christian Church, E: 100 S. Main W: Top of flush mount/
surveys Bolt 1451.40

2 WATER WELL OWNER: Tri-Lakes Petroleum
 RR #, St. Address, Box #: P.O. Box 7500 Board of Agriculture, Division of Water Resources
 City, State, ZIP Code: Branson MO Application Number:

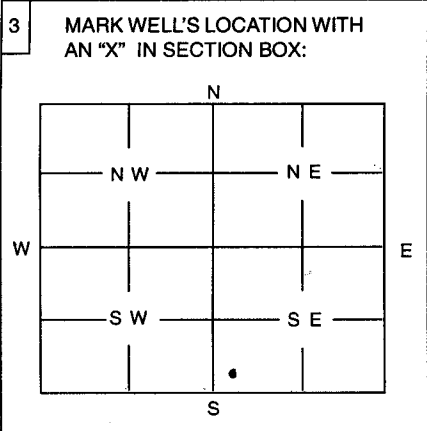

4 DEPTH OF WELL 15.0 ft
 WELL'S STATIC WATER LEVEL 1441.14 ft.
 WELL WAS USED AS:
 1 Domestic 5 Public Water Supply 9 Dewatering
 2 Irrigation 6 Oil Field Water Supply 10 Monitoring Well
 3 Feedlot 7 Domestic (Lawn & Garden) 11 Injection Well
 4 Industrial 8 Air Conditioning 12 Other
 Was a chemical / bacteriological sample submitted to Department? Yes No
 If yes, mo/day/yr sample was submitted
 Water Well Disinfected: Yes No

5 TYPE OF BLANK CASING USED:
 1 Steel 3 RMP (SR) 5 Wrought 7 Fiberglass 9 Other (Specify below)
 PVC 4 ABS NA 6 Asbestos-Cement 8 Concrete Tile
 Blank casing diameter in. Was casing pulled? Yes No If yes, how much 11
 Casing height above or below land surface NA in.

6 GROUT PLUG MATERIAL: 1 Neat cement 2 Cement grout Bentonite 4 Other
 Grout Plug Intervals: From 2 ft. to 15 ft., From ft. to ft., From to ft.
 What is the nearest source of possible contamination:
 1 Septic tank 6 Seepage pit 11 Fuel storage 16 Other (specify below)
 2 Sewer lines 7 Pit privy 12 Fertilizer storage
 3 Watertight sewer lines 8 Sewage lagoon 13 Insecticide storage
 4 Lateral lines 9 Feedyard 14 Abandoned water well
 5 Cess Pool 10 Livestock pens 15 Oil well/Gas well
 Direction from well? How many feet?

FROM	TO	PLUGGING MATERIALS
0	2	concrete
2	15	Bentonite / cement Grout
		well drilled out

7 CONTRACTOR'S OR LANDOWNER'S CERTIFICATION: This water well was plugged under my jurisdiction and was completed on (mo/day/year) 2/12/01 and this record is true to the best of my knowledge and belief. Kansas Water Well Contractor's License No. 668 This Water Well Record was completed on (mo/day/year) 7/16/01 under the business name of Environmental Geoscience & Engineering by (signature) [Signature]

INSTRUCTIONS: Use typewriter or ball point pen. Please press firmly and print clearly. Please fill in blanks, underline or circle the correct answers. Send top three copies to Kansas Department of Health and Environment, Bureau of Water, Topeka, Kansas 66620-0001. Telephone: 785/296-3565. Send one to Water Well Owner and retain one for your records.