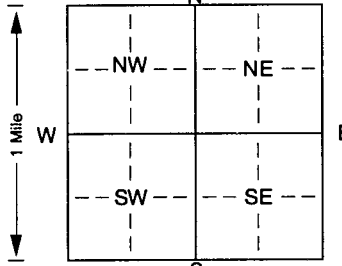


1] LOCATION OF WATER WELL: Fraction NE NE NW SE Section Number 7 Township Number T 23 S Range Number R 1 E EW
 County: Harvey

Distance and direction from nearest town or city street address of well if located within city?
In City Newton 1815 Grandview

2] WATER WELL OWNER: Robb Fidus Board of Agriculture, Division of Water Resources
 RR#, St. Address, Box #: 1815 Grandview Application Number:
 City, State, ZIP Code: Newton, KS 67114

3] LOCATE WELL'S LOCATION WITH AN "X" IN SECTION BOX:

 4] DEPTH OF COMPLETED WELL: 65 ft. ELEVATION:
 Depth(s) Groundwater Encountered 1 40 ft. 2. 15 ft. 3. 4-20-01 ft.
 WELL'S STATIC WATER LEVEL 15 ft. below land surface measured on mo/day/yr
 Pump test data: Well water was 25 gpm; Well water was 55 ft. after 7 hours pumping 65 gpm
 Est. Yield 25 gpm; Well water was 55 ft. after 7 hours pumping 65 gpm
 Bore Hole Diameter: 2 in. to 5.5 ft., and 7 in. to 65 ft.
 WELL WATER TO BE USED AS:
 5 Public water supply 8 Air conditioning 11 Injection well
 1 Domestic 3 Feedlot 6 Oil field water supply 9 Dewatering 12 Other (Specify below)
 2 Irrigation 4 Industrial 7 Domestic (lawn & garden) 10 Monitoring well
 Was a chemical/bacteriological sample submitted to Department? Yes. X No. X; If yes, mo/day/yr sample was submitted
 Water Well Disinfected? Yes X No

5] TYPE OF BLANK CASING USED:
 1 Steel 3 RMP (SR) 5 Wrought iron 8 Concrete tile CASING JOINTS: Glued X Clamped
 2 PVC 4 ABS 6 Asbestos-Cement 9 Other (specify below) Welded
 7 Fiberglass Threaded
 Blank casing diameter 5 in. to 4.5 ft., Dia 5 in. to 65 ft., Dia
 Casing height above land surface 12 in., weight 120 lbs./ft. Wall thickness or gauge No. 2/4
 TYPE OF SCREEN OR PERFORATION MATERIAL:
 1 Steel 3 Stainless steel 5 Fiberglass 7 PVC 10 Asbestos-cement
 2 Brass 4 Galvanized steel 6 Concrete tile 8 RMP (SR) 11 Other (specify)
 9 ABS 12 None used (open hole)
 SCREEN OR PERFORATION OPENINGS ARE:
 1 Continuous slot 5 Gauzed wrapped 8 Saw cut 11 None (open hole)
 2 Louvered shutter 3 Mill slot 6 Wire wrapped 9 Drilled holes
 4 Key punched 7 Torch cut 10 Other (specify)
 SCREEN-PERFORATED INTERVALS: From 40 ft. to 55 ft., From 20 ft. to 65 ft.
 GRAVEL PACK INTERVALS: From 20 ft. to 65 ft., From 20 ft. to 65 ft.

6] GROUT MATERIAL: 1 Neat cement 2 Cement grout 3 Bentonite 4 Other
 Grout Intervals: From 0 ft. to 20 ft., From 20 ft. to 65 ft., From 20 ft. to 65 ft., From 20 ft. to 65 ft.
 What is the nearest source of possible contamination:
 1 Septic tank 4 Lateral lines 7 Pit privy 10 Livestock pens 14 Abandoned water well
 2 Sewer lines 5 Cess pool 8 Sewage lagoon 11 Fuel storage 15 Oil well/Gas well
 3 Watertight sewer lines 6 Seepage pit 9 Feedyard 12 Fertilizer storage 16 Other (specify below)
 13 Insecticide storage
 Direction from well? N How many feet? 27

FROM	TO	LITHOLOGIC LOG	FROM	TO	PLUGGING INTERVALS
<u>0</u>	<u>40</u>	<u>yellow clay</u>			
<u>40</u>	<u>55</u>	<u>Sand medium</u>			
<u>55</u>	<u>65</u>	<u>Blue Shale</u>			

7] CONTRACTOR'S OR LANDOWNER'S CERTIFICATION: This water well was (1) constructed (2) reconstructed, or (3) plugged under my jurisdiction and was completed on (mo/day/year) 4-20-01 and this record is true to the best of my knowledge and belief. Kansas Water Well Contractor's Licence No. 180 This Water Well Record was completed on (mo/day/yr) 4-24-01 under the business name of Backhoe Drilling by (signature) Paul H. Backhoe