

PZ-1


WATER WELL RECORD Form WWC-5 KSA 82a-1212

LOCATION OF WATER WELL: County: <b>Harvey</b>	Fraction <b>SE 1/4 SE 1/4 SE 1/4</b>	Section Number <b>8</b>	Township Number <b>T 23 S</b>	Range Number <b>R 1 EW</b>
--------------------------------------------------	-----------------------------------------	----------------------------	----------------------------------	-------------------------------

Distance and direction from nearest town or city street address of well if located within city?  
**SE corner of 17th & Main Newton, KS.**

WATER WELL OWNER: **KOHE - DFRTF**  
 RR#, St. Address, Box #: **Forbes Field, Bldg 740**  
 City, State, ZIP Code: **Topeka, KS 66620**

Board of Agriculture, Division of Water Resources  
 Application Number:

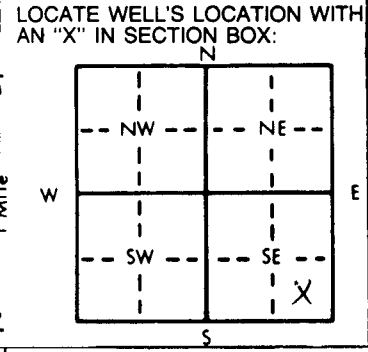

DEPTH OF COMPLETED WELL: **13** ft. ELEVATION: .....

Depth(s) Groundwater Encountered 1. **8.4** ft. 2. .... ft. 3. .... ft.

WELL'S STATIC WATER LEVEL: **8.4** ft. below land surface measured on mo/day/yr .....

Pump test data: Well water was ..... ft. after ..... hours pumping ..... gpm

Est. Yield: **NA** gpm; Well water was ..... ft. after ..... hours pumping ..... gpm

Bore Hole Diameter: **2 1/8** in. to **13** ft., and ..... in. to ..... ft.

WELL WATER TO BE USED AS:

1 Domestic	2 Irrigation	3 Feedlot	4 Industrial	5 Public water supply	6 Oil field water supply	7 Lawn and garden only	8 Air conditioning	9 Dewatering	10 Monitoring well	11 Injection well	12 Other (Specify below)
------------	--------------	-----------	--------------	-----------------------	--------------------------	------------------------	--------------------	--------------	--------------------	-------------------	--------------------------

Was a chemical/bacteriological sample submitted to Department? Yes.....No **X**.....; If yes, mo/day/yr sample was submitted .....

Water Well Disinfected? Yes ..... No **X**.....

TYPE OF BLANK CASING USED:

1 Steel	3 RMP (SR)	5 Wrought iron	8 Concrete tile	CASING JOINTS: Glued ..... Clamped .....
<b>2 PVC</b>	4 ABS	6 Asbestos-Cement	9 Other (specify below)	Welded .....
Blank casing diameter: <b>3/4</b> in. to <b>4</b> in.	Dia. .... in. to ..... in.	7 Fiberglass	10 Asbestos-cement	Threaded .....

Casing height above land surface: **flush** in., weight ..... lbs./ft. Wall thickness or gauge No. **Sch 80**

TYPE OF SCREEN OR PERFORATION MATERIAL:

1 Steel	3 Stainless steel	5 Fiberglass	8 RMP (SR)	10 Asbestos-cement
2 Brass	4 Galvanized steel	6 Concrete tile	9 ABS	11 Other (specify) .....
				12 None used (open hole)

SCREEN OR PERFORATION OPENINGS ARE:

1 Continuous slot	<b>3 Mill slot</b>	5 Gauzed wrapped	8 Saw cut	11 None (open hole)
2 Louvered shutter	4 Key punched	6 Wire wrapped	9 Drilled holes	
		7 Torch cut	10 Other (specify) .....	

SCREEN-PERFORATED INTERVALS: From **4** ft. to **13** ft., From ..... ft. to ..... ft.

GRAVEL PACK INTERVALS: From **2** ft. to **13** ft., From ..... ft. to ..... ft.

GROUT MATERIAL: 1 Neat cement 2 Cement grout **3 Bentonite** 4 Other .....

Grout Intervals: From **0** ft. to **2** ft., From ..... ft. to ..... ft., From ..... ft. to ..... ft.

What is the nearest source of possible contamination:

1 Septic tank	4 Lateral lines	7 Pit privy	10 Livestock pens	14 Abandoned water well
<b>2 Sewer lines</b>	5 Cess pool	8 Sewage lagoon	11 Fuel storage	15 Oil well/Gas well
3 Watertight sewer lines	6 Seepage pit	9 Feedyard	12 Fertilizer storage	16 Other (specify below)
			13 Insecticide storage	

Direction from well? .....

FROM	TO	LITHOLOGIC LOG	FROM	TO	PLUGGING INTERVALS
0	1	Topsoil			
1	8	silty clay			
8	13	silty clay w/ sand			

CONTRACTOR'S OR LANDOWNER'S CERTIFICATION: This water well was **1** constructed, (2) reconstructed, or (3) plugged under my jurisdiction and was completed on (mo/day/year) **5/8/01** and this record is true to the best of my knowledge and belief. Kansas Water Well Contractor's License No. **604** This Water Well Record was completed on (mo/day/yr) **6/11/01** under the business name of **Environmental Priority Service Inc.** by (signature) **[Signature]**

INSTRUCTIONS: Use typewriter or ball point pen. PLEASE PRESS FIRMLY and PRINT clearly. Please fill in blanks, underline or circle the correct answers. Send top three copies to Kansas Department of Health and Environment, Bureau of Water, Topeka, Kansas 66620-0001. Telephone: 913-296-5545. Send one to WATER WELL OWNER and retain one for your records.