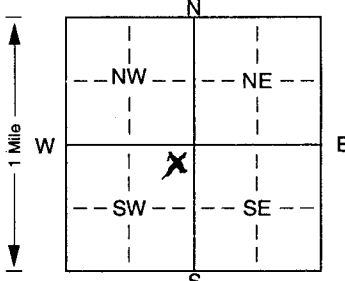


1 LOCATION OF WATER WELL: Fraction Mo 1/4 SW 1/4 SW 1/4 Section Number 5 Township Number T 23 S R 1 Range Number EW
 County: Harvey

Distance and direction from nearest town or city street address of well if located within city?
In City Newton 3016 Wildwood Way

2 WATER WELL OWNER: Jim Kiso
 RR#, St. Address, Box #: 3016 Wildwood Way Board of Agriculture, Division of Water Resources
 City, State, ZIP Code: No. Newton, KS, 67117 Application Number:

3 LOCATE WELL'S LOCATION WITH AN "X" IN SECTION BOX:  4 DEPTH OF COMPLETED WELL: 95 ft. ELEVATION:
 Depth(s) Groundwater Encountered 1. 24 ft. 2. ft. 3. ft.
 WELL'S STATIC WATER LEVEL: 16 ft. below land surface measured on mo/day/yr
 Pump test data: Well water was ft. after hours pumping gpm
 Est. Yield 20 gpm; Well water was ft. after hours pumping gpm
 Bore Hole Diameter: 8 1/2 in. to 50 ft., and 7 1/2 in. to 95 ft.
 WELL WATER TO BE USED AS: 5 Public water supply 8 Air conditioning 11 Injection well
 1 Domestic 3 Feedlot 6 Oil field water supply 9 Dewatering 12 Other (Specify below)
 2 Irrigation 4 Industrial 7 Domestic (lawn & garden) 10 Monitoring well
 Was a chemical/bacteriological sample submitted to Department? Yes. No. X; If yes, mo/day/yr sample was submitted
 Water Well Disinfected? Yes X No

5 TYPE OF BLANK CASING USED: 5 Wrought iron 8 Concrete tile CASING JOINTS: Glued. X Clamped.
 1 Steel 3 RMP (SR) 6 Asbestos-Cement 9 Other (specify below) Welded
2 PVC 4 ABS 7 Fiberglass Threaded.
 Blank casing diameter 5 in. to 24 ft., Dia. in. to ft., Dia. in. to ft.
 Casing height above land surface: 12 in., weight Class 160 lbs./ft. Wall thickness or gauge No. 214
 TYPE OF SCREEN OR PERFORATION MATERIAL: 7 PVC 10 Asbestos-cement
 1 Steel 3 Stainless steel 5 Fiberglass 8 RMP (SR) 11 Other (specify)
 2 Brass 4 Galvanized steel 6 Concrete tile 9 ABS 12 None used (open hole)
 SCREEN OR PERFORATION OPENINGS ARE: 5 Gauzed wrapped 8 Saw cut 11 None (open hole)
 1 Continuous slot 3 Mill slot 6 Wire wrapped 9 Drilled holes
 2 Louvered shutter 4 Key punched 7 Torch cut 10 Other (specify) ft.
 SCREEN-PERFORATED INTERVALS: From 24 ft. to 44 ft., From 75 ft. to 95 ft.
 From ft. to ft., From ft. to ft.
 GRAVEL PACK INTERVALS: From 20 ft. to 95 ft., From ft. to ft.
 From ft. to ft., From ft. to ft.

6 GROUT MATERIAL: 1 Neat cement 2 Cement grout 3 Bentonite 4 Other
 Grout intervals: From 0 ft. to 20 ft., From ft. to ft., From ft. to ft.
 What is the nearest source of possible contamination:
 1 Septic tank 4 Lateral lines 7 Pit privy 10 Livestock pens 14 Abandoned water well
 2 Sewer lines 5 Cess pool 8 Sewage lagoon 11 Fuel storage 15 Oil well/Gas well
 3 Watertight sewer lines 6 Seepage pit 9 Feedyard 12 Fertilizer storage 16 Other (specify below)
 13 Insecticide storage
 Direction from well? SW How many feet? 35

| FROM | TO | LITHOLOGIC LOG | FROM | TO | PLUGGING INTERVALS |
|------|----|-------------------------------|------|----|--------------------|
| 0 | 22 | yellow clay | | | |
| 22 | 26 | fine sand | | | |
| 26 | 32 | clay | | | |
| 32 | 45 | Sand mixed clay | | | |
| 45 | 80 | Blue + Gray Shale | | | |
| 80 | 85 | Broken Shale + Possible water | | | |
| 85 | 95 | Gray Shale | | | |

7 CONTRACTOR'S OR LANDOWNER'S CERTIFICATION: This water well was (1) constructed, (2) reconstructed, or (3) plugged under my jurisdiction and was completed on (mo/day/year) 6-5-01 and this record is true to the best of my knowledge and belief. Kansas Water Well Contractor's Licence No. 180 This Water Well Record was completed on (mo/day/yr) 6-22-01 under the business name of Bachhus Drilling by (signature) Paul H. Bachhus