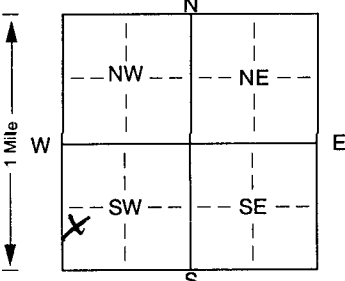


1 LOCATION OF WATER WELL: Fraction NW 1/4 SW 1/4 SW 1/4 Section Number 5 Township Number T 23 S R 1 Range Number 1 E
 County: Hanway

Distance and direction from nearest town or city street address of well if located within city?
2704 Acacia in No Newton

2 WATER WELL OWNER: Neal Denno
 RR#, St. Address, Box #: 2704 Acacia Board of Agriculture, Division of Water Resources
 City, State, ZIP Code: No Newton, KS 67817 Application Number:

3 LOCATE WELL'S LOCATION WITH AN "X" IN SECTION BOX:


4 DEPTH OF COMPLETED WELL: 106 ft. ELEVATION:
 Depth(s) Groundwater Encountered 1. 1.7 ft. 2. 6-19-01 ft. 3. 6-19-01 ft.
 WELL'S STATIC WATER LEVEL 1.7 ft. below land surface measured on mo/day/yr
 Pump test data: Well water was 45 ft. after 1 hours pumping 20 gpm
 Est. Yield 20 gpm: Well water was 45 ft. after 1 hours pumping 20 gpm
 Bore Hole Diameter: 9 in. to 3.6 ft., and 5 3/4 in. to 106 ft.
 WELL WATER TO BE USED AS: 5 Public water supply 8 Air conditioning 11 Injection well
 1 Domestic 3 Feedlot 6 Oil field water supply 9 Dewatering 12 Other (Specify below)
 2 Irrigation 4 Industrial 7 Domestic (lawn & garden) 10 Monitoring well
 Was a chemical/bacteriological sample submitted to Department? Yes. X No. X; If yes, mo/day/yr sample was submitted
 Water Well Disinfected? Yes X No

5 TYPE OF BLANK CASING USED:
 1 Steel 3 RMP (SR) 5 Wrought iron 8 Concrete tile CASING JOINTS: Glued X Clamped
PVC 4 ABS 7 Fiberglass Welded
 Blank casing diameter 6 in. to 36 ft., Dia. 6 in. to 36 ft., Dia. 6 in. to 36 ft.
 Casing height above land surface: 12 in., weight 140 lbs./ft. Wall thickness or gauge No. 140
 TYPE OF SCREEN OR PERFORATION MATERIAL:
 1 Steel 3 Stainless steel 5 Fiberglass 7 PVC 10 Asbestos-cement
 2 Brass 4 Galvanized steel 6 Concrete tile 8 RMP (SR) 11 Other (specify)
 SCREEN OR PERFORATION OPENINGS ARE:
 1 Continuous slot 3 Mill slot 5 Gauzed wrapped 8 Saw cut 9 None (open hole)
 2 Louvered shutter 4 Key punched 6 Wire wrapped 9 Drilled holes
 7 Torch cut 10 Other (specify) 9 ft.
 SCREEN-PERFORATED INTERVALS: From 0 ft. to 30 ft., From 30 ft. to 106 ft.
 GRAVEL PACK INTERVALS: From 0 ft. to 30 ft., From 30 ft. to 106 ft.

6 GROUT MATERIAL: 1 Neat cement 2 Cement grout 3 Bentonite 4 Other
 Grout Intervals: From 2 ft. to 22 ft., From 31 ft. to 36 ft., From 36 ft. to 106 ft.
 What is the nearest source of possible contamination:
 1 Septic tank 4 Lateral lines 7 Pit privy 10 Livestock pens 14 Abandoned water well
 2 Sewer lines 5 Cess pool 8 Sewage lagoon 11 Fuel storage 15 Oil well/Gas well
9 Watertight sewer lines 6 Seepage pit 9 Feedyard 12 Fertilizer storage 16 Other (specify below)
 13 Insecticide storage
 Direction from well? E How many feet? 30

FROM	TO	LITHOLOGIC LOG	FROM	TO	PLUGGING INTERVALS
0	30	Br & Gr Clay			
30	106	Shale			

7 CONTRACTOR'S OR LANDOWNER'S CERTIFICATION: This water well was 1 constructed, (2) reconstructed, or (3) plugged under my jurisdiction and was completed on (mo/day/year) 6-19-01 and this record is true to the best of my knowledge and belief. Kansas Water Well Contractor's Licence No. 447 This Water Well Record was completed on (mo/day/year) 7-4-01 under the business name of Miller Drilling by (signature) E Miller