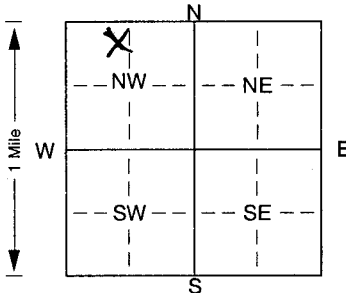


1 LOCATION OF WATER WELL: Fraction	Section Number	Township Number	Range Number
County: <u>Harvey</u> <u>1/2 1/4 NW 1/4 NW 1/4</u>	<u>35</u>	T <u>23</u> S	R <u>1</u> <u>EW</u>

Distance and direction from nearest town or city street address of well if located within city?

1 3/4 E 25 Newton2 WATER WELL OWNER: Rodean DrenksenRR#, St. Address, Box # : 3229 SE 24th
City, State, ZIP Code : Newton, KS. 67114Board of Agriculture, Division of Water Resources
Application Number:3 LOCATE WELL'S LOCATION WITH 4 DEPTH OF COMPLETED WELL. 48 ft. ELEVATION:

AN "X" IN SECTION BOX:

Depth(s) Groundwater Encountered 15 ft. 2. 30 ft. 3. 48 ft.
WELL'S STATIC WATER LEVEL 15 ft. below land surface measured on mo/day/yr 7-5-01Pump test data: Well water was _____ ft. after _____ hours pumping _____ gpm
Est. Yield 20 gpm: Well water was _____ ft. after _____ hours pumping _____ gpm
Bore Hole Diameter 9 in. to 48 ft. and _____ in. to _____ ft.WELL WATER TO BE USED AS: 5 Public water supply 8 Air conditioning 11 Injection well
1 Domestic 3 Feedlot 6 Oil field water supply 9 Dewatering 12 Other (Specify below)
2 Irrigation 4 Industrial 7 Domestic (lawn & garden) 10 Monitoring wellWas a chemical/bacteriological sample submitted to Department? Yes. _____ No. X; If yes, mo/day/yr sample was submitted
Water Well Disinfected? Yes X No5 TYPE OF BLANK CASING USED: 5 Wrought iron 8 Concrete tile CASING JOINTS: Glued. X Clamped. _____1 Steel 3 RMP (SR) 6 Asbestos-Cement 9 Other (specify below) Welded _____
2 PVC 4 ABS 7 Fiberglass Threaded _____Blank casing diameter 5 in. to 35 ft. Dia _____ in. to _____ ft. Dia _____ in. to _____ ft.Casing height above land surface 12 in., weight Class 160 lbs./ft. Wall thickness or gauge No. 214

TYPE OF SCREEN OR PERFORATION MATERIAL:

1 Steel 3 Stainless steel 5 Fiberglass 8 RMP (SR) 10 Asbestos-cement
2 Brass 4 Galvanized steel 6 Concrete tile 9 ABS 11 Other (specify) _____
12 None used (open hole)

SCREEN OR PERFORATION OPENINGS ARE:

1 Continuous slot 3 Mill slot 5 Gauzed wrapped 8 Saw cut 11 None (open hole)
2 Louvered shutter 4 Key punched 6 Wire wrapped 9 Drilled holes
7 Torch cut 10 Other (specify) _____ ft.SCREEN-PERFORATED INTERVALS: From 35 ft. to 48 ft., From _____ ft. to _____ ft.GRAVEL PACK INTERVALS: From 20 ft. to 48 ft., From _____ ft. to _____ ft.
From _____ ft. to _____ ft., From _____ ft. to _____ ft.

6 GROUT MATERIAL: 1 Neat cement 2 Cement grout 3 Bentonite 4 Other _____

Grout intervals: From 0 ft. to 20 ft., From _____ ft. to _____ ft., From _____ ft. to _____ ft.

What is the nearest source of possible contamination:

1 Septic tank 4 Lateral lines 7 Pit privy 10 Livestock pens 14 Abandoned water well
2 Sewer lines 5 Cess pool 8 Sewage lagoon 11 Fuel storage 15 Oil well/Gas well
3 Watertight sewer lines 6 Seepage pit 9 Feedyard 12 Fertilizer storage 16 Other (specify below) _____
13 Insecticide storageDirection from well? Will be NW How many feet? Will be 150'

FROM TO LITHOLOGIC LOG FROM TO PLUGGING INTERVALS

0 24 Clay24 35 fine Sand35 46 Med Sand46 48 Gray Shale7 CONTRACTOR'S OR LANDOWNER'S CERTIFICATION: This water well was (1) constructed, (2) reconstructed, or (3) plugged under my jurisdiction and wascompleted on (mo/day/year) 7-5-01 and this record is true to the best of my knowledge and belief. KansasWater Well Contractor's Licence No. 1200 This Water Well Record was completed on (mo/day/year) 7-11-01under the business name of Backhus Drilling by (signature) Paul H. Backhus