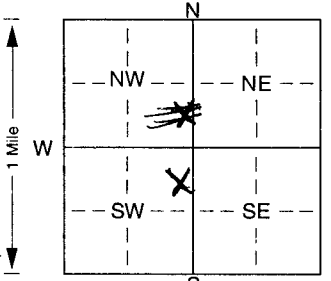


1 LOCATION OF WATER WELL: Fraction Ne 1/4 Ne 1/4 SW 1/4 Section Number 7 Township Number T 23 S Range Number R 1 E
 County: Harvey

Distance and direction from nearest town or city street address of well if located within city?
In City Newton 904 W 17th St.

2 WATER WELL OWNER: Don Wedel
 RR#, St. Address, Box # : 904 W 17th St. Board of Agriculture, Division of Water Resources
 City, State, ZIP Code : Newton, KS, 67114 Application Number:

3 LOCATE WELL'S LOCATION WITH AN "X" IN SECTION BOX:

 4 DEPTH OF COMPLETED WELL: 70 ft. ELEVATION:
 Depth(s) Groundwater Encountered 1. 37 ft. 2. 37 ft. 3. 37 ft.
 WELL'S STATIC WATER LEVEL: 23 ft. below land surface measured on mo/day/yr 7-24-01
 Pump test data: Well water was 7 ft. after 7 1/2 hours pumping 10-15 gpm
 Est. Yield 10-15 gpm: Well water was 7 ft. after 7 1/2 hours pumping 10-15 gpm
 Bore Hole Diameter: 9 in. to 50 ft., and 7 1/2 in. to 70 ft.
 WELL WATER TO BE USED AS:
 5 Public water supply 8 Air conditioning 11 Injection well
 1 Domestic 3 Feedlot 6 Oil field water supply 9 Dewatering 12 Other (Specify below)
 2 Irrigation 4 Industrial 7 Domestic (lawn & garden) 10 Monitoring well
 Was a chemical/bacteriological sample submitted to Department? Yes. X No. X; If yes, mo/day/yr sample was submitted
 Water Well Disinfected? Yes X No

5 TYPE OF BLANK CASING USED:
 1 Steel 3 RMP (SR) 5 Wrought iron 8 Concrete tile CASING JOINTS: Glued X Clamped
 2 PVC 4 ABS 7 Fiberglass 9 Other (specify below) Welded
 11 Threaded
 Blank casing diameter 5 in. to 36 ft. Dia. 5 in. to 55 ft. Dia. 12 in. to 160 ft. Dia. 2 1/4 lbs./ft. Wall thickness or gauge No. 2 1/4
 Casing height above land surface 12 in., weight 120 lbs./ft.
 TYPE OF SCREEN OR PERFORATION MATERIAL:
 1 Steel 3 Stainless steel 5 Fiberglass 7 PVC 10 Asbestos-cement
 2 Brass 4 Galvanized steel 6 Concrete tile 8 RMP (SR) 11 Other (specify)
 9 ABS 12 None used (open hole)
 SCREEN OR PERFORATION OPENINGS ARE:
 1 Continuous slot 3 Mill slot 5 Gauzed wrapped 8 Saw cut 11 None (open hole)
 2 Louvered shutter 4 Key punched 6 Wire wrapped 9 Drilled holes
 7 Torch cut 10 Other (specify) 10 ft.
 SCREEN-PERFORATED INTERVALS: From 36 ft. to 46 ft., From 55 ft. to 70 ft.
 From 36 ft. to 46 ft., From 55 ft. to 70 ft.
 GRAVEL PACK INTERVALS: From 20 ft. to 70 ft., From 55 ft. to 70 ft.
 From 20 ft. to 70 ft., From 55 ft. to 70 ft.

6 GROUT MATERIAL: 1 Neat cement 2 Cement grout 3 Bentonite 4 Other
 Grout Intervals: From 0 ft. to 20 ft., From 20 ft. to 70 ft., From 55 ft. to 70 ft.
 What is the nearest source of possible contamination:
 1 Septic tank 4 Lateral lines 7 Pit privy 10 Livestock pens 14 Abandoned water well
 2 Sewer lines 5 Cess pool 8 Sewage lagoon 11 Fuel storage 15 Oil well/Gas well
 3 Watertight sewer lines 6 Seepage pit 9 Feedyard 12 Fertilizer storage 16 Other (specify below)
 13 Insecticide storage
 Direction from well? SW How many feet? 15

FROM	TO	LITHOLOGIC LOG	FROM	TO	PLUGGING INTERVALS
<u>0</u>	<u>20</u>	<u>Clay</u>			
<u>20</u>	<u>37</u>	<u>Sandy Clay</u>			
<u>37</u>	<u>47</u>	<u>fine to med sand</u>			
<u>47</u>	<u>60</u>	<u>Blue Shale</u>			
<u>60</u>	<u>66</u>	<u>Broken Shale some water</u>			
<u>66</u>	<u>70</u>	<u>Gray Shale</u>			

7 CONTRACTOR'S OR LANDOWNER'S CERTIFICATION: This water well was (1) constructed, (2) reconstructed, or (3) plugged under my jurisdiction and was completed on (mo/day/year) 7-24-01 and this record is true to the best of my knowledge and belief. Kansas Water Well Contractor's Licence No. 120 This Water Well Record was completed on (mo/day/yr) 7-24-01 under the business name of Backhoe Drilling by (signature) Paul H. Backhoe