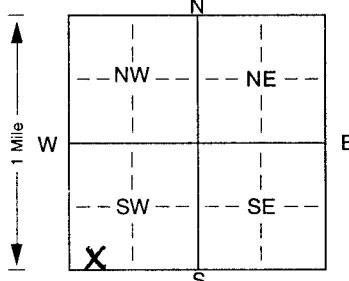


1 LOCATION OF WATER WELL: Fraction SW 1/4 SW 1/4 SW 1/4 Section Number 7 Township Number T 23 S S Range Number R 1 EW  
 County: Harvey

Distance and direction from nearest town or city street address of well if located within city?  
In City Newton W 12th + Columbus

2 WATER WELL OWNER: Ron TV + Electronics  
 RR#, St. Address, Box #: W 12th + Columbus  
 City, State, ZIP Code: Newton, KS. 67114  
 Board of Agriculture, Division of Water Resources  
 Application Number:

3 LOCATE WELL'S LOCATION WITH AN "X" IN SECTION BOX:  
  
 4 DEPTH OF COMPLETED WELL: 70 ft. ELEVATION:  
 Depth(s) Groundwater Encountered 14 33 ft. 2. 62 ft. 3. ft.  
 WELL'S STATIC WATER LEVEL 14 ft. below land surface measured on mo/day/yr 7-24-01  
 Pump test data: Well water was ft. after hours pumping gpm  
 Est. Yield 20 gpm; Well water was ft. after hours pumping gpm  
 Bore Hole Diameter: 4 in. to 50 ft., and 7 1/2 in. to 70 ft.  
 WELL WATER TO BE USED AS:  
 1 Domestic 3 Feedlot 6 Oil field water supply 9 Dewatering 12 Other (Specify below)  
 2 Irrigation 4 Industrial 7 Domestic (lawn & garden) 10 Monitoring well  
 Was a chemical/bacteriological sample submitted to Department? Yes. No. X; If yes, mo/day/yrs sample was submitted  
 Water Well Disinfected? Yes X No

5 TYPE OF BLANK CASING USED:  
 1 Steel 3 RMP (SR) 6 Asbestos-Cement 9 Other (specify below) Welded  
 2 PVC 4 ABS 7 Fiberglass Threaded  
 Blank casing diameter 5 in. to 30 ft., Dia 5 in. to 60 ft., Dia in. to ft.  
 Casing height above land surface 12 in., weight CLASS 160 lbs./ft. Wall thickness or gauge No. 214  
 TYPE OF SCREEN OR PERFORATION MATERIAL:  
 1 Steel 3 Stainless steel 5 Fiberglass 8 RMP (SR) 11 Other (specify)  
 2 Brass 4 Galvanized steel 6 Concrete tile 9 ABS 12 None used (open hole)  
 SCREEN OR PERFORATION OPENINGS ARE:  
 1 Continuous slot 3 Mill slot 5 Gauzed wrapped 8 Saw cut 11 None (open hole)  
 2 Louvered shutter 4 Key punched 6 Wire wrapped 9 Drilled holes  
 7 Torch cut 10 Other (specify) ft.  
 SCREEN-PERFORATED INTERVALS: From 30 ft. to 40 ft., From 60 ft. to 75 ft.  
 From ft. to ft., From ft. to ft.  
 GRAVEL PACK INTERVALS: From 20 ft. to 70 ft., From ft. to ft.  
 From ft. to ft., From ft. to ft.

6 GROUT MATERIAL: 1 Neat cement 2 Cement grout 3 Bentonite 4 Other  
 Grout Intervals: From 0 ft. to 20 ft., From ft. to ft., From ft. to ft.  
 What is the nearest source of possible contamination:  
 1 Septic tank 4 Lateral lines 7 Pit privy 11 Fuel storage 15 Oil well/Gas well  
 2 Sewer lines 5 Cess pool 8 Sewage lagoon 12 Fertilizer storage 16 Other (specify below)  
 3 Watertight sewer lines 6 Seepage pit 9 Feedyard 13 Insecticide storage  
 Direction from well? E How many feet? 60

FROM	TO	LITHOLOGIC LOG	FROM	TO	PLUGGING INTERVALS
<u>0</u>	<u>30</u>	<u>Clay</u>			
<u>30</u>	<u>40</u>	<u>Sand</u>			
<u>40</u>	<u>62</u>	<u>Blue Shale</u>			
<u>62</u>	<u>65</u>	<u>Broken Shale + Water</u>			
<u>65</u>	<u>70</u>	<u>Gray Shale</u>			

7 CONTRACTOR'S OR LANDOWNER'S CERTIFICATION: This water well was (1) constructed, (2) reconstructed, or (3) plugged under my jurisdiction and was completed on (mo/day/year) 7-24-01 and this record is true to the best of my knowledge and belief. Kansas Water Well Contractor's Licence No. 180 This Water Well Record was completed on (mo/day/yr) 7-24-01 under the business name of Backhus Drilling by (signature) Paul H. Backhus