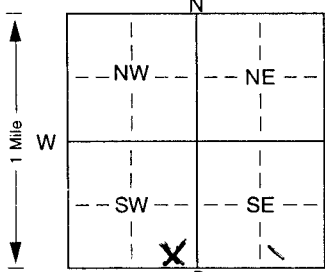


1 LOCATION OF WATER WELL: Fraction Se 1/4 Se 1/4 QW 1/4 Section Number 5 Township Number T 23 S Range Number R 1 E  
 County: Harvey

Distance and direction from nearest town or city street address of well if located within city?  
In City Newton ~~3029~~ ~~3049~~ 304 W 24th

2 WATER WELL OWNER: Jon Jantz  
 RR#, St. Address, Box # : 304 W 24th Board of Agriculture, Division of Water Resources  
 City, State, ZIP Code : N. Newton, KS. 67117 Application Number:

3 LOCATE WELL'S LOCATION WITH AN "X" IN SECTION BOX:  
  
 4 DEPTH OF COMPLETED WELL: 70 ft. ELEVATION:  
 Depth(s) Groundwater Encountered 1. 18 ft. 2. 60 ft. 3.          ft.  
 WELL'S STATIC WATER LEVEL 15 ft. below land surface measured on mo/day/yr  
 Pump test data: Well water was          ft. after          hours pumping          gpm  
 Est. Yield 25-30 gpm: Well water was          ft. after          hours pumping          gpm  
 Bore Hole Diameter: 9 in. to 35 ft., and 7 1/2 in. to 70 ft.  
 WELL WATER TO BE USED AS: 5 Public water supply 8 Air conditioning 11 Injection well  
 1 Domestic 3 Feedlot 6 Oil field water supply 9 Dewatering 12 Other (Specify below)  
 2 Irrigation 4 Industrial 7 Domestic (lawn & garden) 10 Monitoring well  
 Was a chemical/bacteriological sample submitted to Department? Yes.          No. X; If yes, mo/day/yr sample was submitted  
 Water Well Disinfected? Yes X No         

5 TYPE OF BLANK CASING USED: 5 Wrought iron 8 Concrete tile CASING JOINTS: Glued X Clamped           
 1 Steel 3 RMP (SR) 6 Asbestos-Cement 9 Other (specify below) Welded           
 2 PVC 4 ABS 7 Fiberglass Threaded           
 Blank casing diameter 5 in. to 18 ft., Dia 5 in. to 50 ft., Dia          in. to          ft.  
 Casing height above land surface 12 in., weight Class 2 160 lbs./ft. Wall thickness or gauge No. 214  
 TYPE OF SCREEN OR PERFORATION MATERIAL: 7 PVC 10 Asbestos-cement  
 1 Steel 3 Stainless steel 5 Fiberglass 8 RMP (SR) 11 Other (specify)           
 2 Brass 4 Galvanized steel 6 Concrete tile 9 ABS 12 None used (open hole)  
 SCREEN OR PERFORATION OPENINGS ARE: 5 Gauzed wrapped 8 Saw cut 11 None (open hole)  
 1 Continuous slot 3 Mill slot 6 Wire wrapped 9 Drilled holes  
 2 Louvered shutter 4 Key punched 7 Torch cut 10 Other (specify)          ft.  
 SCREEN-PERFORATED INTERVALS: From 18 ft. to 28 ft., From 50 ft. to 70 ft.  
 From          ft. to          ft., From          ft. to          ft.  
 GRAVEL PACK INTERVALS: From 18 ft. to 70 ft., From          ft. to          ft.  
 From          ft. to          ft., From          ft. to          ft.

6 GROUT MATERIAL: 1 Neat cement 2 Cement grout 3 Bentonite 4 Other           
 Grout Intervals: From 0 ft. to 18 ft., From          ft. to          ft., From          ft. to          ft.  
 What is the nearest source of possible contamination:  
 1 Septic tank 4 Lateral lines 7 Pit privy 10 Livestock pens 14 Abandoned water well  
 2 Sewer lines 5 Cess pool 8 Sewage lagoon 11 Fuel storage 15 Oil well/Gas well  
 3 Watertight sewer lines 6 Seepage pit 9 Feedyard 12 Fertilizer storage 16 Other (specify below)  
 13 Insecticide storage  
 Direction from well? SE How many feet? 42

FROM	TO	LITHOLOGIC LOG	FROM	TO	PLUGGING INTERVALS
0	18	Clay			
18	28	Sand			
28	60	Blue & Gray Shale			
60	65	Broken Shale & Water			
65	70	Gray Shale			

7 CONTRACTOR'S OR LANDOWNER'S CERTIFICATION: This water well was (1) constructed, (2) reconstructed, or (3) plugged under my jurisdiction and was completed on (mo/day/year) 12-1-01 and this record is true to the best of my knowledge and belief. Kansas Water Well Contractor's Licence No. 180 This Water Well Record was completed on (mo/day/yr) 12-3-01 under the business name of Backhoe Drilling by (signature) Paul J. Backhoe