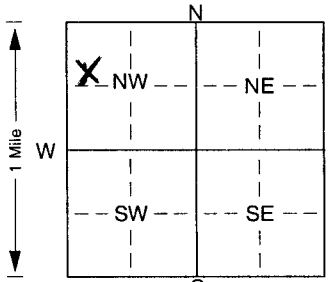


1 LOCATION OF WATER WELL: Fraction SW 1/4 NW 1/4 NW 1/4 Section Number 8 Township Number T 23 S R 1 Range Number 1 EDN  
 County: Harvey

Distance and direction from nearest town or city street address of well if located within city?  
1/2 E Newton on 24th

2 WATER WELL OWNER: Emerson Weins  
 RR#, St. Address, Box # : Box 143 Board of Agriculture, Division of Water Resources  
 City, State, ZIP Code : M. Newton, KS 67117-93 Application Number:

3 LOCATE WELL'S LOCATION WITH AN "X" IN SECTION BOX:  
  
 4 DEPTH OF COMPLETED WELL: 18 ft. ELEVATION: 25 ft.  
 Depth(s) Groundwater Encountered 18 ft. 2. 25 ft. 3.     ft.  
 WELL'S STATIC WATER LEVEL 10 ft. below land surface measured on mo/day/yr     /     /      
 Pump test data: Well water was     ft. after     hours pumping     gpm  
 Est. Yield 10-15 gpm: Well water was     ft. after     hours pumping     gpm  
 Bore Hole Diameter: 9 in. to 35 ft., and 7 1/2 in. to 93 ft.  
 WELL WATER TO BE USED AS: 5 Public water supply 8 Air conditioning 11 Injection well  
 1 Domestic 3 Feedlot 6 Oil field water supply 9 Dewatering 12 Other (Specify below)  
 2 Irrigation 4 Industrial 7 Domestic (lawn & garden) 10 Monitoring well      
 Was a chemical/bacteriological sample submitted to Department? Yes.     No. X; If yes, mo/day/yr sample was submitted     Water Well Disinfected? Yes X No    

5 TYPE OF BLANK CASING USED: 5 Wrought iron 8 Concrete tile CASING JOINTS: Glued Y Clamped      
 1 Steel 3 RMP (SR) 6 Asbestos-Cement 9 Other (specify below) Welded      
2 PVC 4 ABS 7 Fiberglass Threaded      
 Blank casing diameter 5 in. to 15 ft., Dia. 5 in. to 60 ft., Dia.     in. to     ft.  
 Casing height above land surface 12 in., weight 12.88 lbs./ft. Wall thickness or gauge No. 214  
 TYPE OF SCREEN OR PERFORATION MATERIAL: 7 PVC 10 Asbestos-cement  
 1 Steel 3 Stainless steel 5 Fiberglass 8 RMP (SR) 11 Other (specify)      
 2 Brass 4 Galvanized steel 6 Concrete tile 9 ABS 12 None used (open hole)  
 SCREEN OR PERFORATION OPENINGS ARE: 5 Gauzed wrapped 8 Saw cut 11 None (open hole)  
 1 Continuous slot 3 Mill slot 6 Wire wrapped 9 Drilled holes  
 2 Louvered shutter 4 Key punched 7 Torch cut 10 Other (specify)     ft.  
 SCREEN-PERFORATED INTERVALS: From 18 ft. to 22 ft., From 60 ft. to 90 ft.  
 From     ft. to     ft., From     ft. to     ft.  
 GRAVEL PACK INTERVALS: From 15 ft. to 35 ft., From     ft. to     ft.  
 From     ft. to     ft., From     ft. to     ft.

6 GROUT MATERIAL: 1 Neat cement 2 Cement grout 3 Bentonite 4 Other      
 Grout Intervals: From 10 ft. to 15 ft., From     ft. to     ft., From     ft. to     ft.  
 What is the nearest source of possible contamination:  
 1 Septic tank 4 Lateral lines 7 Pit privy 10 Livestock pens 14 Abandoned water well  
 2 Sewer lines 5 Cess pool 8 Sewage lagoon 11 Fuel storage 15 Oil well/Gas well  
 3 Watertight sewer lines 6 Seepage pit 9 Feedyard 12 Fertilizer storage 16 Other (specify below)      
 13 Insecticide storage      
 Direction from well? House not Built yet How many feet? Will be 100 +

FROM	TO	LITHOLOGIC LOG	FROM	TO	PLUGGING INTERVALS
0	15	Clay			
15	24	Sand			
24	25	Blue-Gray Shale			
25	90	Broken Shale & Possible Water			
90	93	Gray Rock			

7 CONTRACTOR'S OR LANDOWNER'S CERTIFICATION: This water well was (1) constructed, (2) reconstructed, or (3) plugged under my jurisdiction and was completed on (mo/day/year) 7-30-01 and this record is true to the best of my knowledge and belief. Kansas Water Well Contractor's Licence No. 180 This Water Well Record was completed on (mo/day/yr) 8-3-01 under the business name of Backhoe Drilling by (signature) Paul R. Backhoe