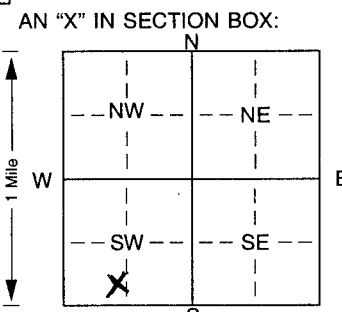


1 LOCATION OF WATER WELL: Fraction <u>Se 1/4 SW 1/4 SW 1/4</u> Section Number <u>5</u> Township Number <u>T 23 S R 1</u> Range Number <u>1</u> <u>EA</u>
--

Distance and direction from nearest town or city street address of well if located within city?
In City Newton West 24th

2 WATER WELL OWNER: Joh Stocky
 RR#, St. Address, Box # : 2527 S. Hoover Rd Board of Agriculture, Division of Water Resources
 City, State, ZIP Code : Newton, KS 67114 Application Number:

3 LOCATE WELL'S LOCATION WITH AN "X" IN SECTION BOX:  4 DEPTH OF COMPLETED WELL: 77 ft. ELEVATION: 10-19-01
 Depth(s) Groundwater Encountered 1. 77 ft. 2. . ft. 3. . ft.
 WELL'S STATIC WATER LEVEL 2.1 ft. below land surface measured on mo/day/yr 10-19-01
 Pump test data: Well water was . ft. after . hours pumping . gpm
 Est. Yield 2.0 gpm; Well water was . ft. after . hours pumping . gpm
 Bore Hole Diameter: 9 in. to 3.5 ft., and 7 in. to 2.8 ft.
 WELL WATER TO BE USED AS: 5 Public water supply 8 Air conditioning 11 Injection well
 1 Domestic 3 Feedlot 6 Oil field water supply 9 Dewatering 12 Other (Specify below)
 2 Irrigation 4 Industrial 7 Domestic (lawn & garden) 10 Monitoring well
 Was a chemical/bacteriological sample submitted to Department? Yes. . No. X; If yes, mo/day/yr sample was submitted
 Water Well Disinfected? Yes X No

5 TYPE OF BLANK CASING USED: 1 Steel 3 RMP (SR) 5 Wrought iron 8 Concrete tile CASING JOINTS: Glued. X Clamped. .
 2 PVC 4 ABS 6 Asbestos-Cement 9 Other (specify below) Welded .
 7 Fiberglass Threaded.
 Blank casing diameter 5 in. to 9.0 ft., Dia. . in. to . ft., Dia. . in. to . ft.
 Casing height above land surface 12 in., weight Class 90 lbs./ft. Wall thickness or gauge No. 214
 TYPE OF SCREEN OR PERFORATION MATERIAL: 7 PVC 10 Asbestos-cement
 1 Steel 3 Stainless steel 5 Fiberglass 8 RMP (SR) 11 Other (specify) .
 2 Brass 4 Galvanized steel 6 Concrete tile 9 ABS 12 None used (open hole)
 SCREEN OR PERFORATION OPENINGS ARE: 5 Gauzed wrapped 8 Saw cut 11 None (open hole)
 1 Continuous slot 3 Mill slot 6 Wire wrapped 9 Drilled holes
 2 Louvered shutter 4 Key punched 7 Torch cut 10 Other (specify) . ft.
 SCREEN-PERFORATED INTERVALS: From 30 ft. to 2.8 ft., From . ft. to . ft.
 From . ft. to . ft., From . ft. to . ft.
 GRAVEL PACK INTERVALS: From 2.0 ft. to 2.8 ft., From . ft. to . ft.
 From . ft. to . ft., From . ft. to . ft.

6 GROUT MATERIAL: 1 Neat cement 2 Cement grout 3 Bentonite 4 Other .
 Grout Intervals: From 0 ft. to 2.0 ft., From . ft. to . ft., From . ft. to . ft.
 What is the nearest source of possible contamination:
 1 Septic tank 4 Lateral lines 7 Pit privy 10 Livestock pens 14 Abandoned water well
 2 Sewer lines 5 Cess pool 8 Sewage lagoon 11 Fuel storage 15 Oil well/Gas well
 3 Watertight sewer lines 6 Seepage pit 9 Feedyard 12 Fertilizer storage 16 Other (specify below)
 13 Insecticide storage
 Direction from well? SW How many feet? 50 +

FROM	TO	LITHOLOGIC LOG	FROM	TO	PLUGGING INTERVALS
<u>0</u>	<u>25</u>	<u>Clay</u>			
<u>25</u>	<u>30</u>	<u>Sandy Clay</u>			
<u>30</u>	<u>35</u>	<u>Sand</u>			
<u>35</u>	<u>77</u>	<u>Blue Shale</u>			
<u>77</u>	<u>78</u>	<u>Water</u>			
<u>78</u>	<u>2.8</u>	<u>Blue Shale</u>			

7 CONTRACTOR'S OR LANDOWNER'S CERTIFICATION: This water well was (1) constructed, (2) reconstructed, or (3) plugged under my jurisdiction and was completed on (mo/day/year) 10-19-01 and this record is true to the best of my knowledge and belief. Kansas Water Well Contractor's Licence No. 120 This Water Well Record was completed on (mo/day/yr) 10-24-01 under the business name of Beckhus Drilling by (signature) Jay Beckhus