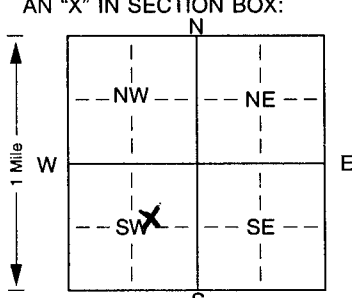


1 LOCATION OF WATER WELL: Fraction SW 1/4 NE 1/4 SW 1/4 Section Number D Township Number T 23 Range Number S R 1
 County: Harvey E/W

Distance and direction from nearest town or city street address of well if located within city?
In City Newton 407 Morningside Rd

2 WATER WELL OWNER: James Antonowich
 RR#, St. Address, Box #: 407 Morningside Rd. Board of Agriculture, Division of Water Resources
 City, State, ZIP Code: Newton, KS Application Number:

3 LOCATE WELL'S LOCATION WITH AN "X" IN SECTION BOX:


4 DEPTH OF COMPLETED WELL: 65 ft. ELEVATION:
 Depth(s) Groundwater Encountered 1. 25-35 ft. 2. .ft. 3. .ft.
 WELL'S STATIC WATER LEVEL: 12 ft. below land surface measured on mo/day/yr
 Pump test data: Well water was .ft. after .hours pumping .gpm
 Est. Yield 20 gpm Well water was .ft. after .hours pumping .gpm
 Bore Hole Diameter: 2 1/2 in. to 50 ft., and ? in. to 65 ft.
 WELL WATER TO BE USED AS:
 5 Public water supply 8 Air conditioning 11 Injection well
 1 Domestic 3 Feedlot 6 Oil field water supply 9 Dewatering 12 Other (Specify below)
 2 Irrigation 4 Industrial 7 Domestic (lawn & garden) 10 Monitoring well
 Was a chemical/bacteriological sample submitted to Department? Yes. No. X ; If yes, mo/day/yr sample was submitted
 Water Well Disinfected? Yes X No

5 TYPE OF BLANK CASING USED:
 1 Steel 3 RMP (SR) 5 Wrought iron 8 Concrete tile CASING JOINTS: Glued. X Clamped.
 2 PVC 4 ABS 6 Asbestos-Cement 9 Other (specify below) Welded
 7 Fiberglass Threaded.
 Blank casing diameter: 5 in. to 20 ft., Dia. 5 in. to 65 ft., Dia.
 Casing height above land surface: 12 in., weight Class 160 lbs./ft. Wall thickness or gauge No. 2.14
 TYPE OF SCREEN OR PERFORATION MATERIAL:
 1 Steel 3 Stainless steel 5 Fiberglass 7 PVC 10 Asbestos-cement
 2 Brass 4 Galvanized steel 6 Concrete tile 8 RMP (SR) 11 Other (specify)
 9 ABS 12 None used (open hole)
 SCREEN OR PERFORATION OPENINGS ARE:
 1 Continuous slot 3 Mill slot 5 Gauzed wrapped 8 Saw cut 11 None (open hole)
 2 Louvered shutter 4 Key punched 6 Wire wrapped 9 Drilled holes
 7 Torch cut 10 Other (specify) .ft.
 SCREEN-PERFORATED INTERVALS: From 20 ft. to 40 ft., From .ft. to .ft.
 GRAVEL PACK INTERVALS: From 20 ft. to 65 ft., From .ft. to .ft.

6 GROUT MATERIAL: 1 Neat cement 2 Cement grout 3 Bentonite 4 Other
 Grout Intervals: From 0 ft. to 20 ft., From .ft. to .ft., From .ft. to .ft.
 What is the nearest source of possible contamination:
 1 Septic tank 4 Lateral lines 7 Pit privy 10 Livestock pens 14 Abandoned water well
 2 Sewer lines 5 Cess pool 8 Sewage lagoon 11 Fuel storage 15 Oil well/Gas well
 3 Watertight sewer lines 6 Seepage pit 9 Feedyard 12 Fertilizer storage 16 Other (specify below)
 13 Insecticide storage
 Direction from well? How many feet?

FROM	TO	LITHOLOGIC LOG	FROM	TO	PLUGGING INTERVALS
0	25	Clay			
25	37	Sand & Water			
37	40	Lime			
40	65	Blue Shale			

7 CONTRACTOR'S OR LANDOWNER'S CERTIFICATION: This water well was (1) constructed, (2) reconstructed, or (3) plugged under my jurisdiction and was completed on (mo/day/year) 6-18-02 and this record is true to the best of my knowledge and belief. Kansas Water Well Contractor's Licence No. 180 This Water Well Record was completed on (mo/day/yr) 6-18-02 under the business name of Backhus Drilling by (signature) Paul H. Backhus